


A. N. S. CO., N. Y.

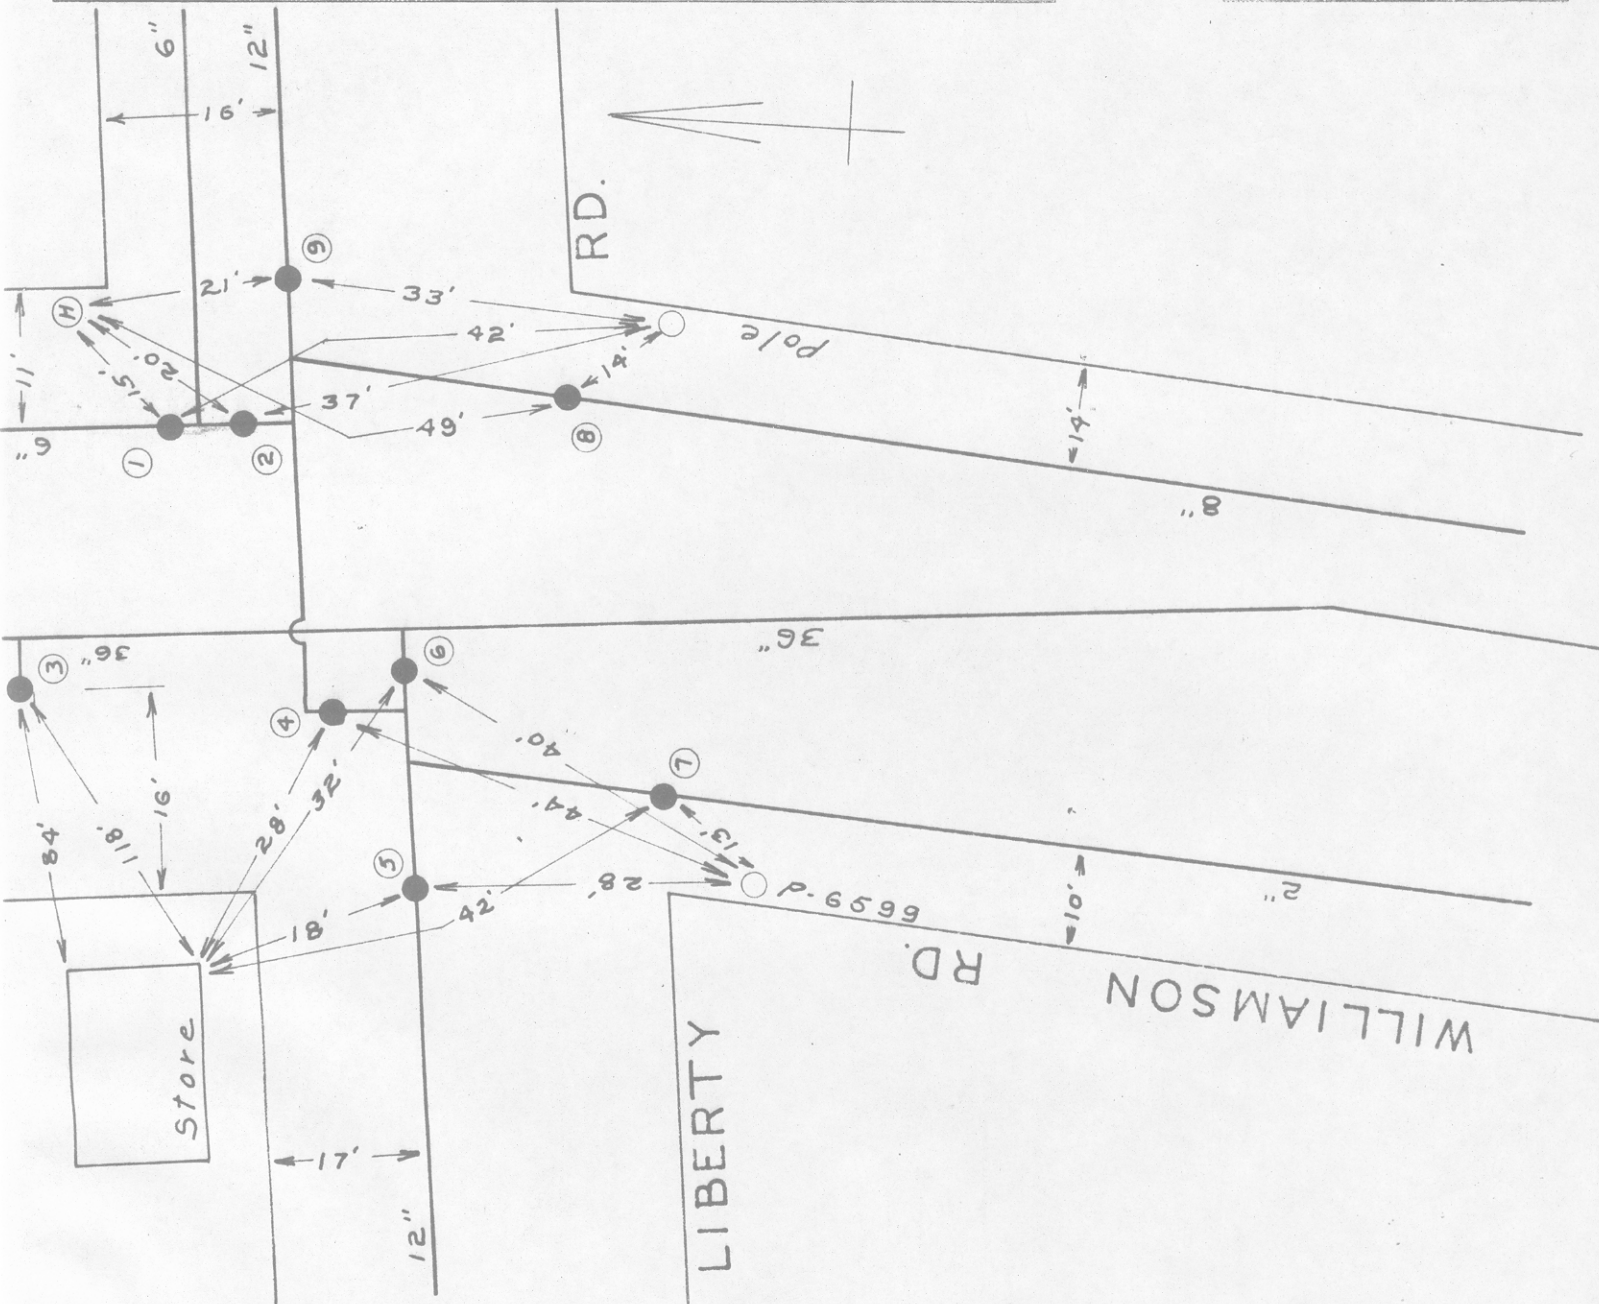

NPL	NPL	NPL	NPL	NPL
NPL	NPL	WPL	SPL	EPL

PAGE NO.