


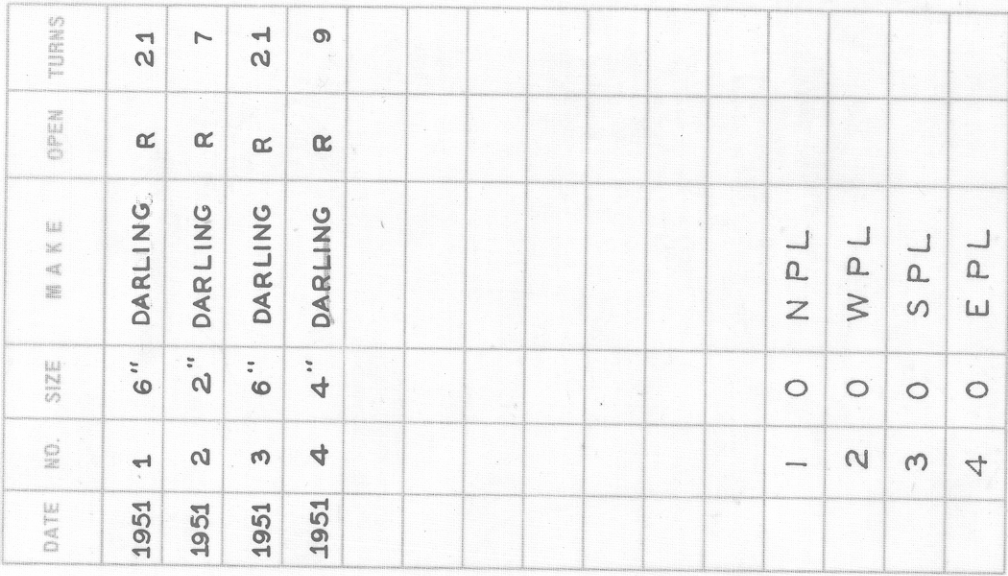

DATE 1/17/51 PAGE NO. N.W. 328