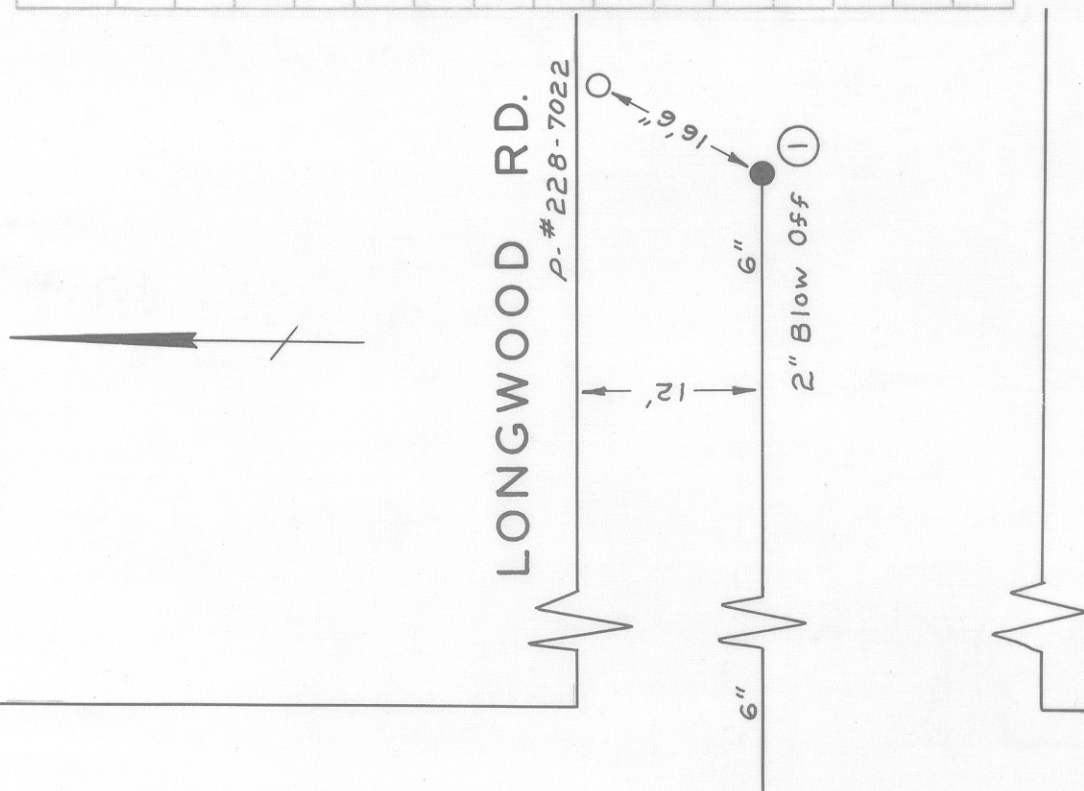


PETERS CREEK ROAD

[illegible]

CITY OF ROANOKE — WATER DEPT.
VALVE DIAGRAM

LONGWOOD ROAD N.W.
AT END OF STREET

SEC. MAP 277

DATE _____

PAGE NO.