


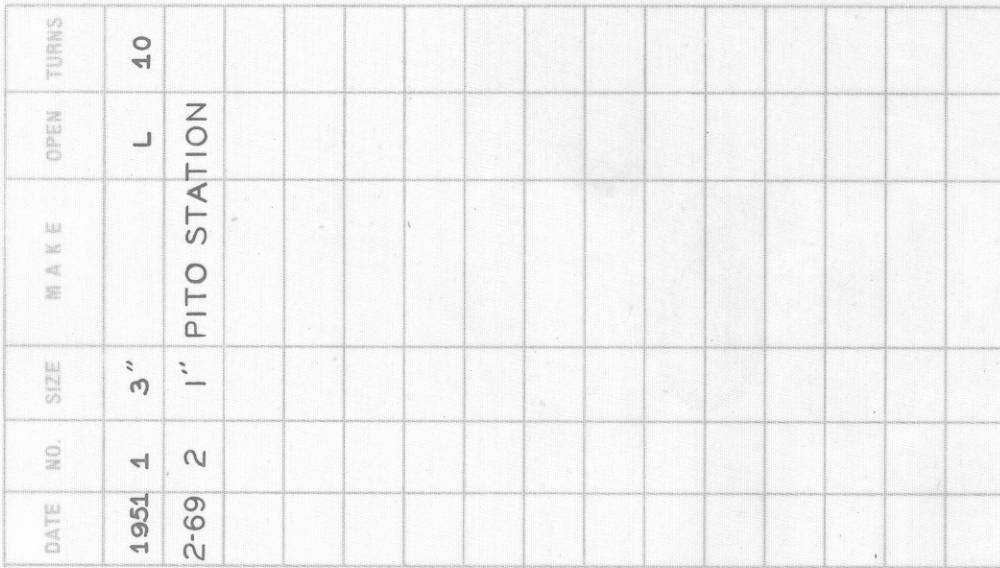

DATE 1/17/51 PAGE NO. NW 327