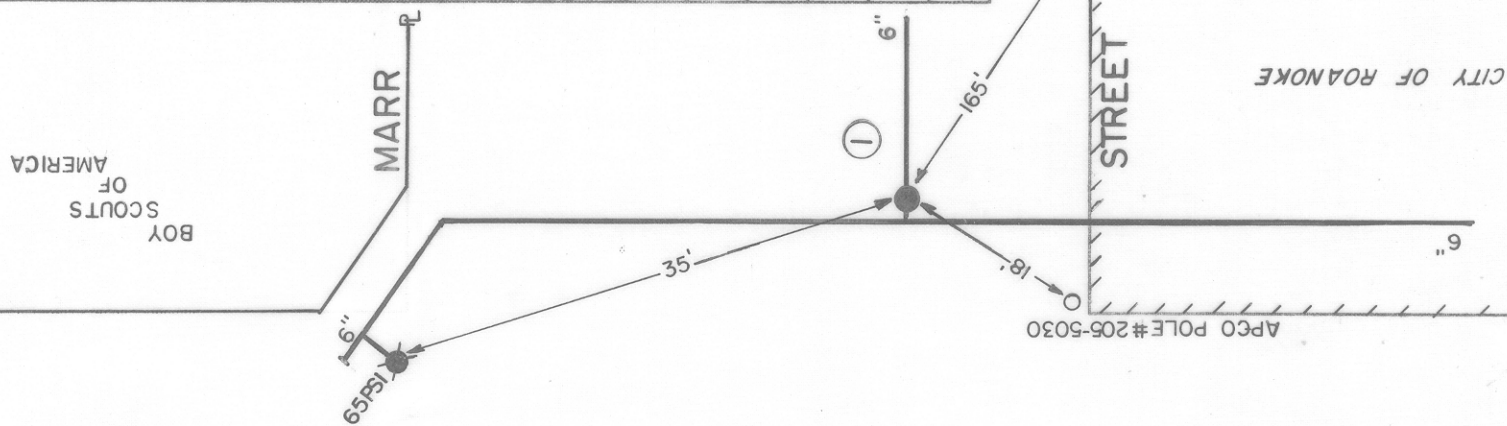


[illegible]

CITY OF ROANOKE—WATER DEPT		
VALVE DIAGRAM		
MARR STREET		
VALLEY VIEW BOULEVARD		
SEC. MAP 227,238	N.W.	
DATE	PAGE NO.	