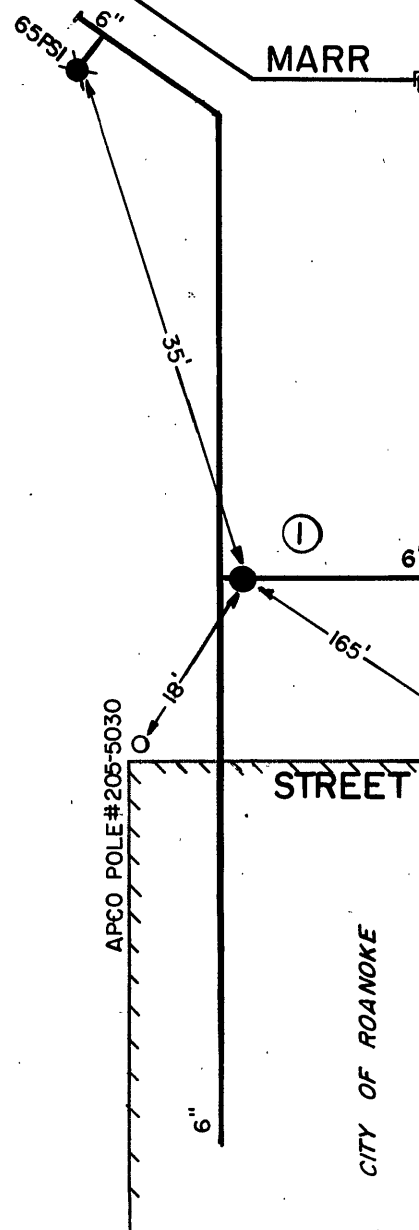


VALLEY

BOY SCOUTS
OF
AMERICA

[illegible]

CITY OF ROANOKE—WATER DEPT' VALVE DIAGRAM

MARR STREET

VALLEY VIEW BOULEVARD

SEC. MAP 227, 238

N.W.

DATE _____

PAGE NO.