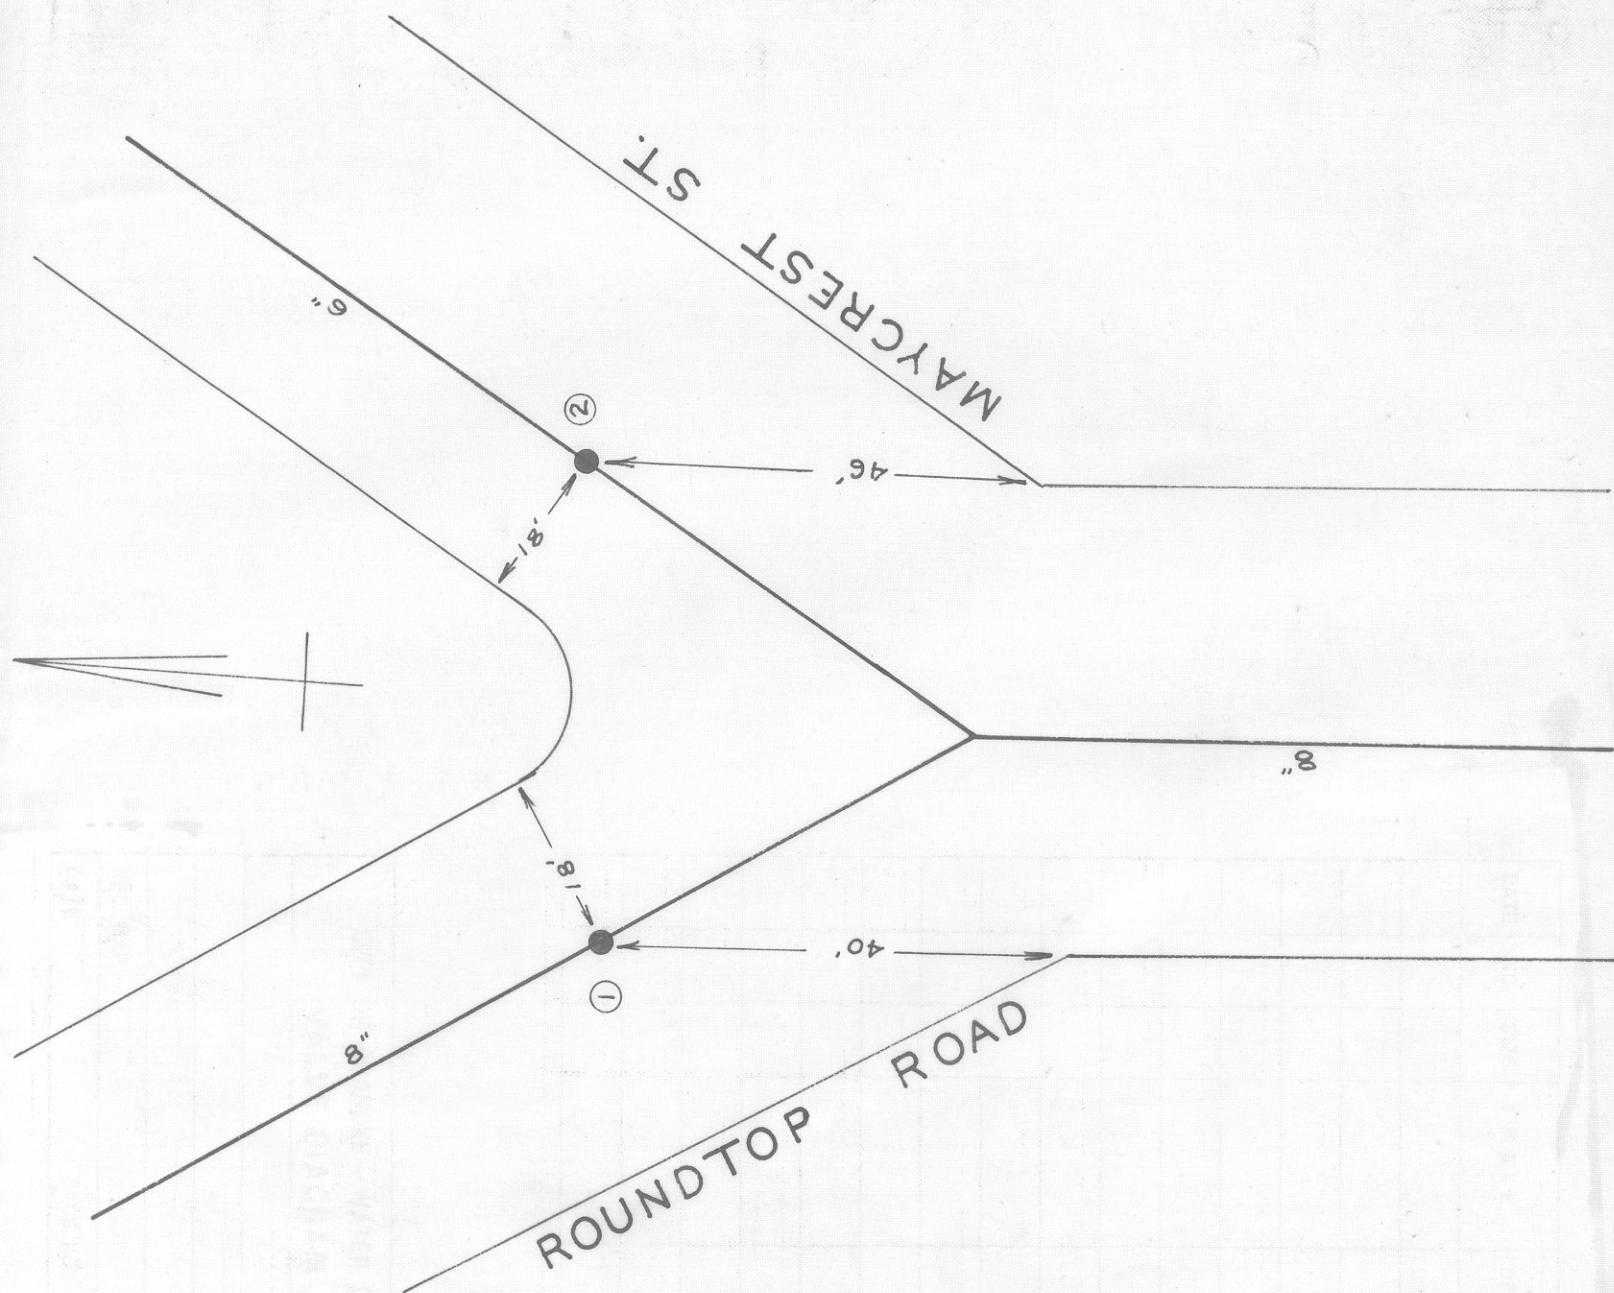


[illegible]

CITY OF NOBLES - WARE

MAYCREST ST. & ROUND

SEC. MAP 215

PAGE NO.