


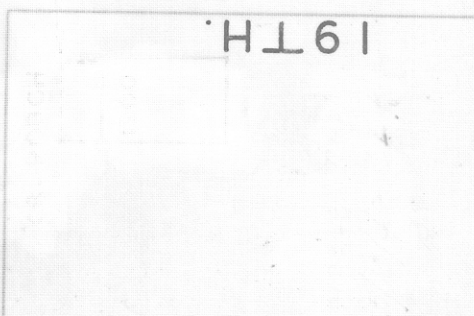

CITY OF ROANOKE—WATER DEPT
VALVE DIAGRAM
MELROSE AVE. & 19TH.
ST. N.W.
SEC. MAP 232
DATE PAGE NO. N.W.201