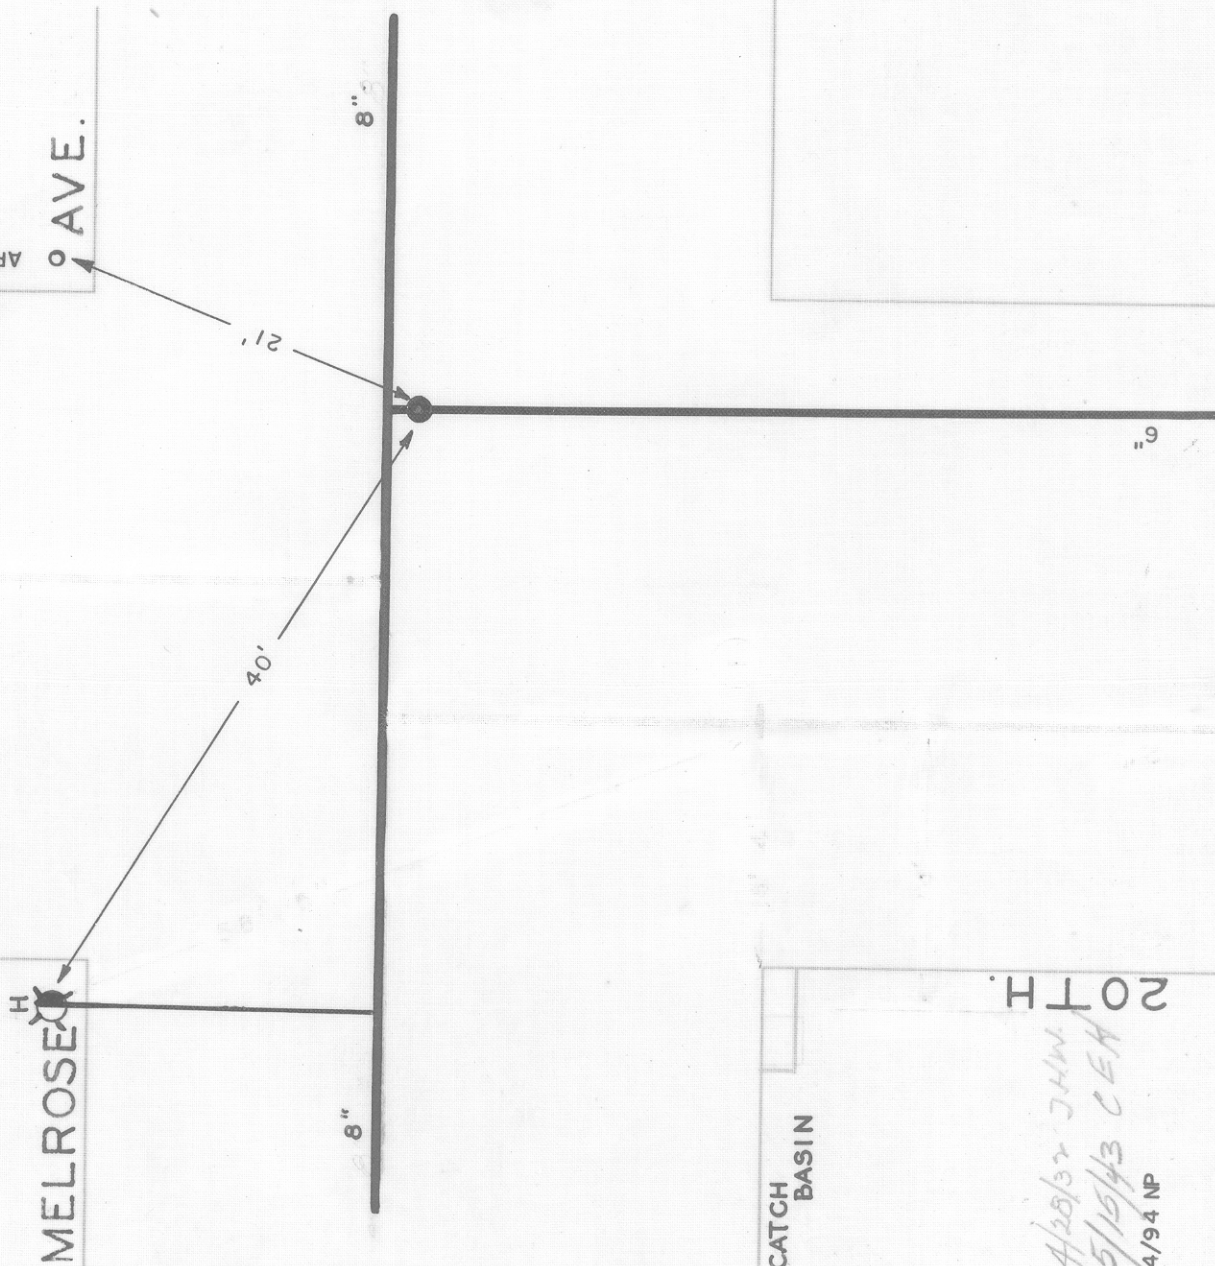


[illegible]

CITY OF ROANOKE—WATER DEPT

VALVE DIAGRAM

MELROSE AVE. & 20TH.

ST. N. W.

SEC. MAP 232

DATE _____

PAGE NO. NW 202

CATCH BASIN

20TH.

4/28/32 JH/W.
5/15/43 CEA
4/94 NP