


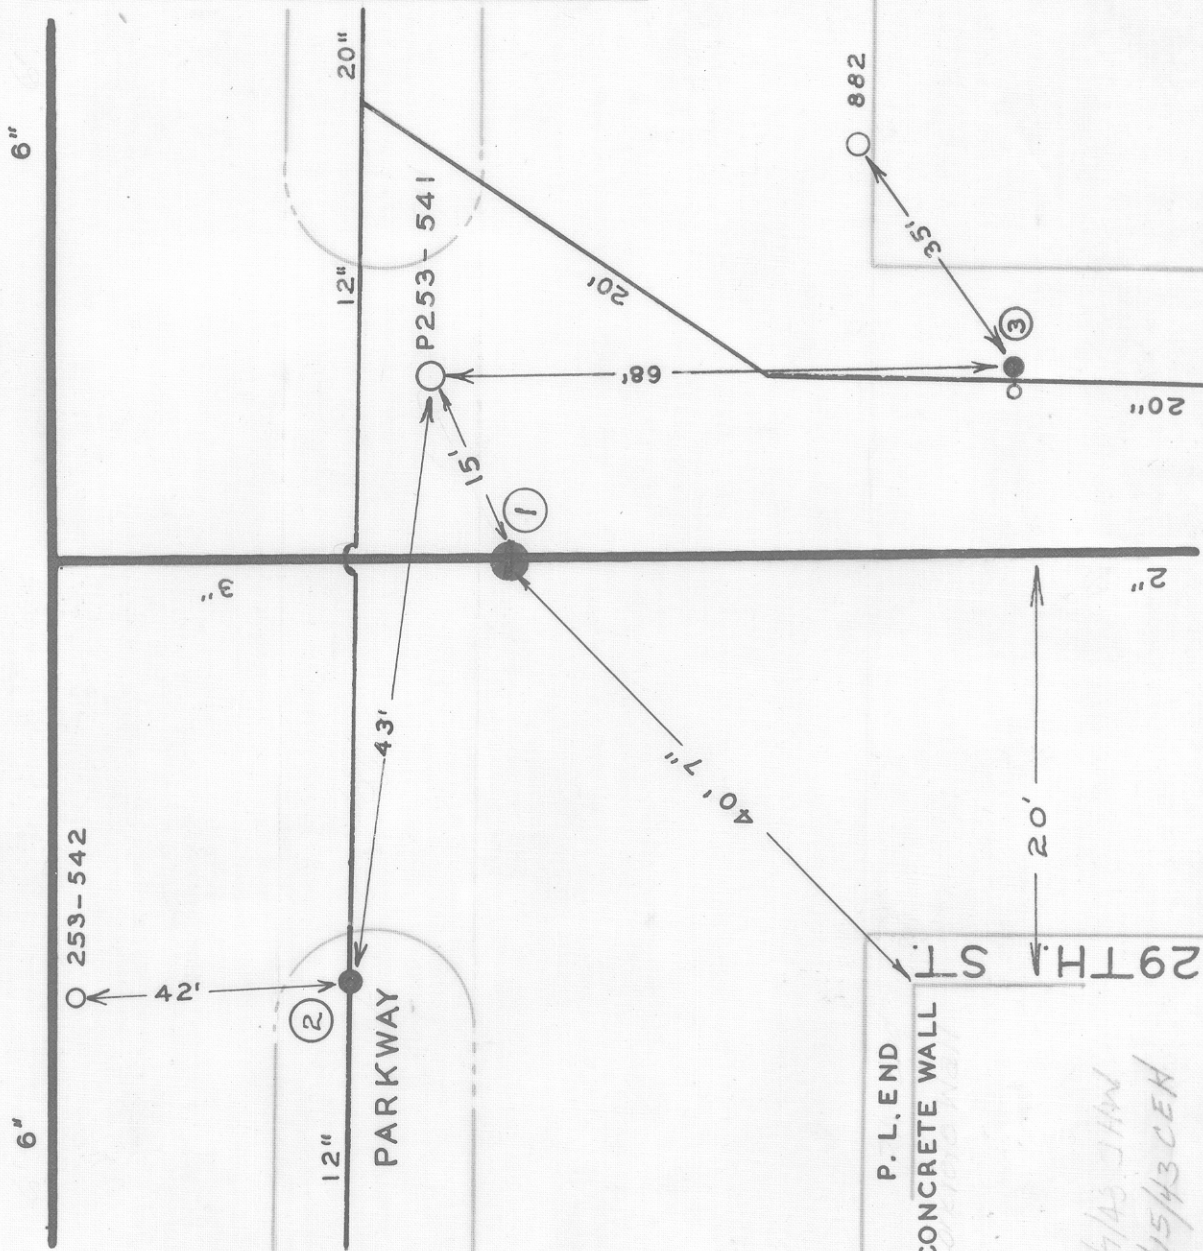

CITY OF ROANOKE—WATER DEPT				
VALVE DIAGRAM				
MELROSE AVE & 29TH.				
ST. N. W.				
SEC. MAP	243			
DATE		PAGE NO	NW 247	

CONCRETE WALL

5/9/43 JHW
5/15/43 CEH