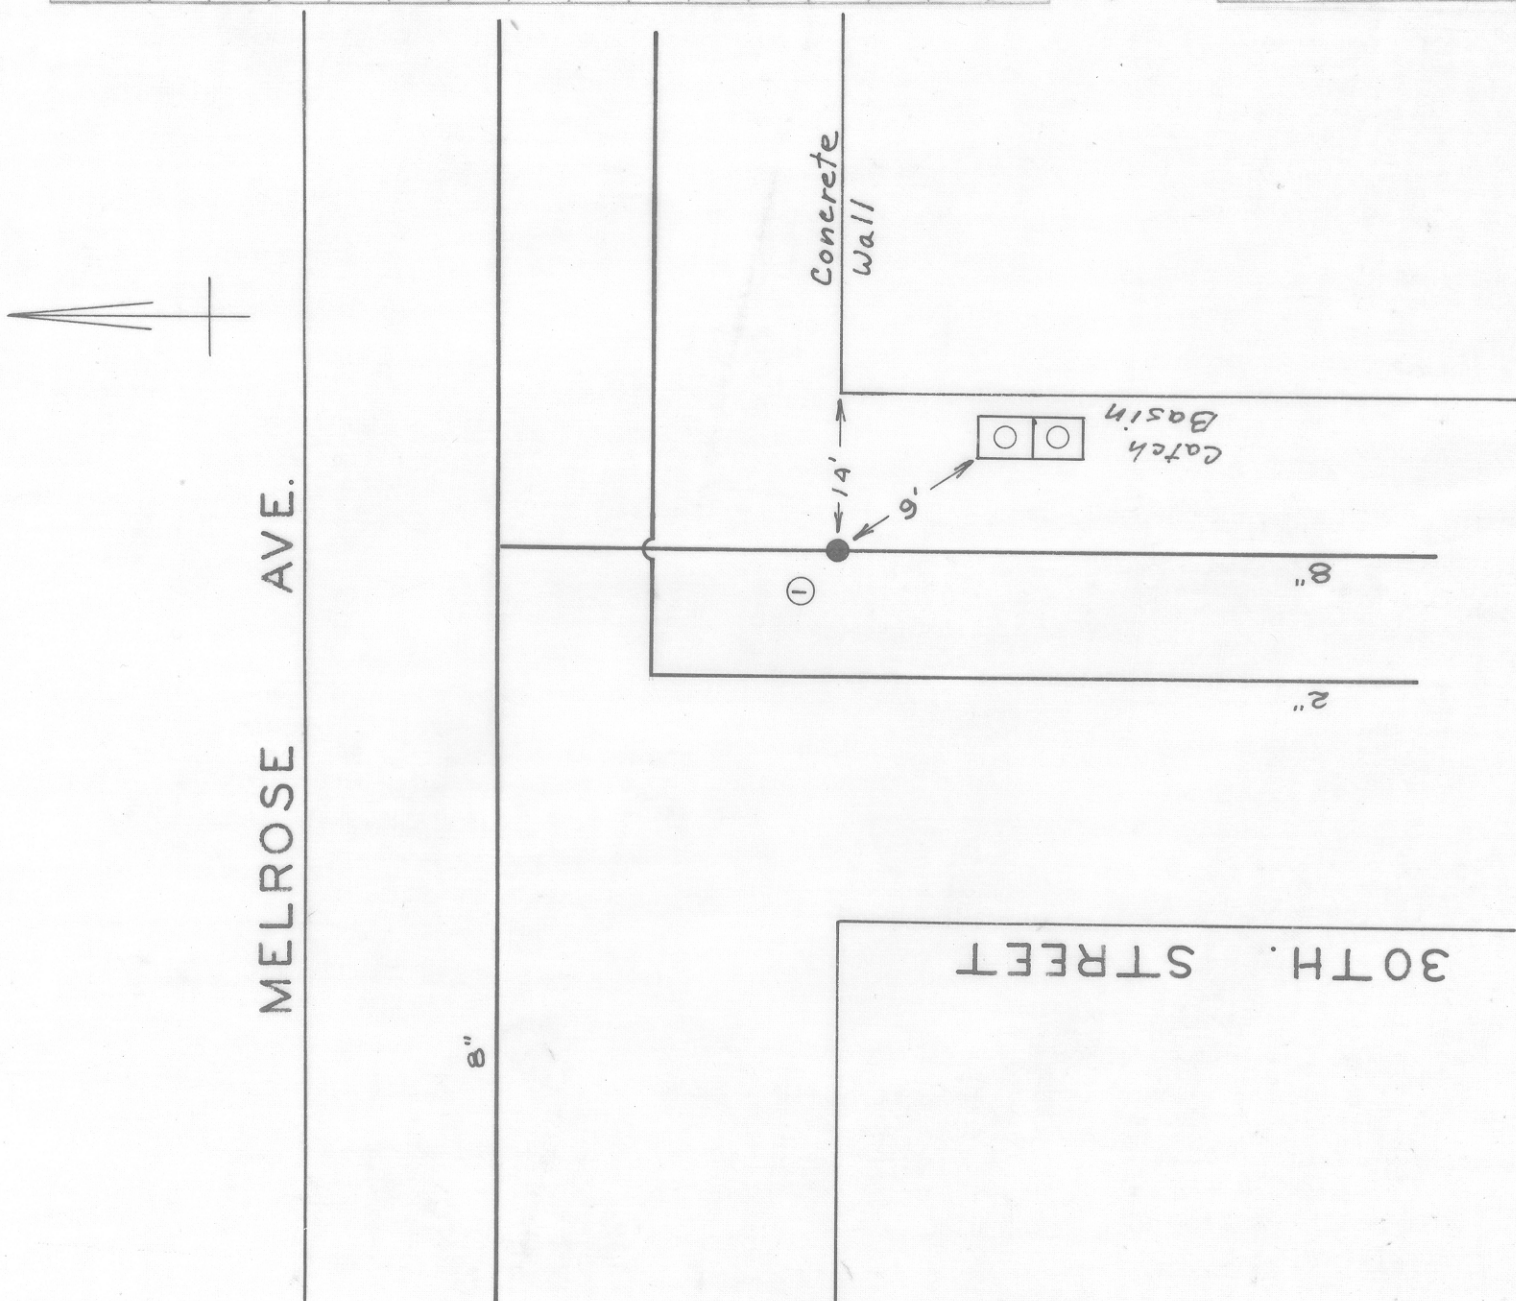


[illegible]

CITY OF ROANOKE - WATER DEPT.
VALVE DIAGRAM
MELROSE AVE. & 30TH.
ST. N.W.
SEC. MAP 253
DATE
PAGE NO.