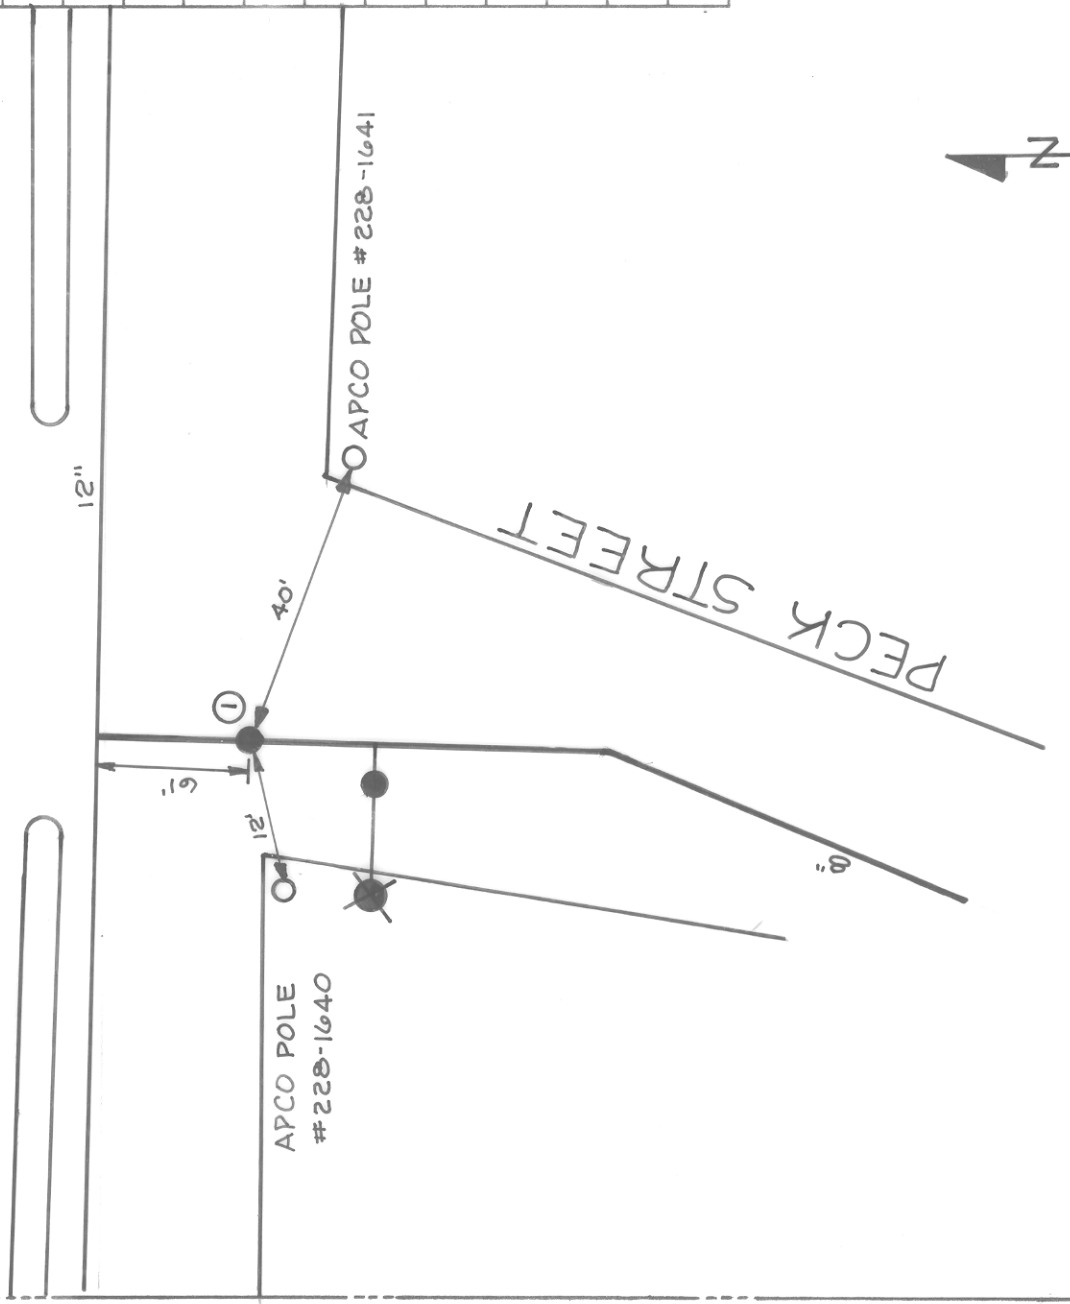


[illegible]

|                            |  |  |          |
|----------------------------|--|--|----------|
| CITY OF ROANOKE—WATER DEPT |  |  |          |
| VALVE DIAGRAM              |  |  |          |
| MELROSE AVE. AND           |  |  |          |
| PECK ST.                   |  |  |          |
|                            |  |  | N.W.     |
| SEC. MAP 609               |  |  |          |
| DATE 8-81                  |  |  | PAGE NO. |