


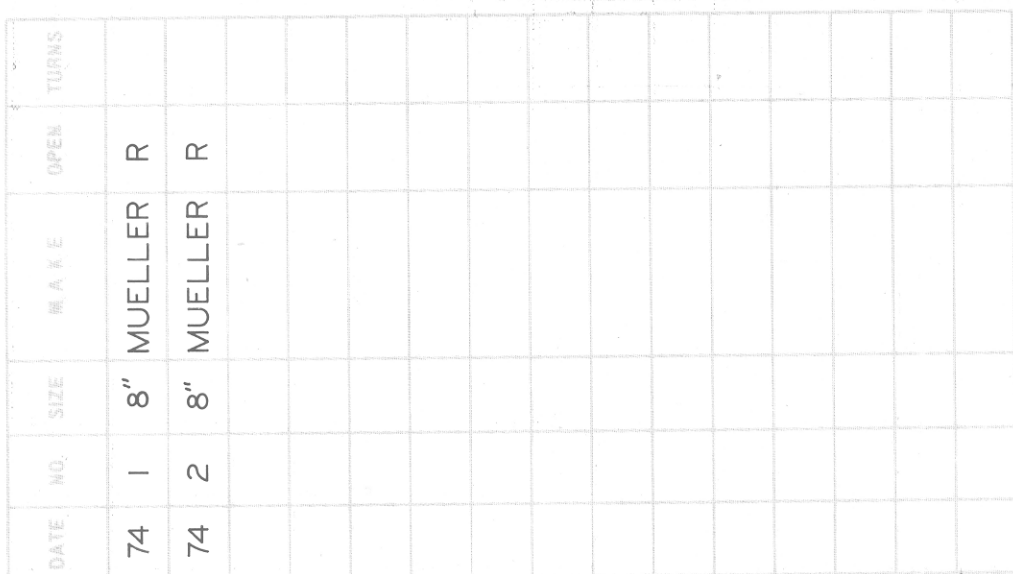

7/2000 JH