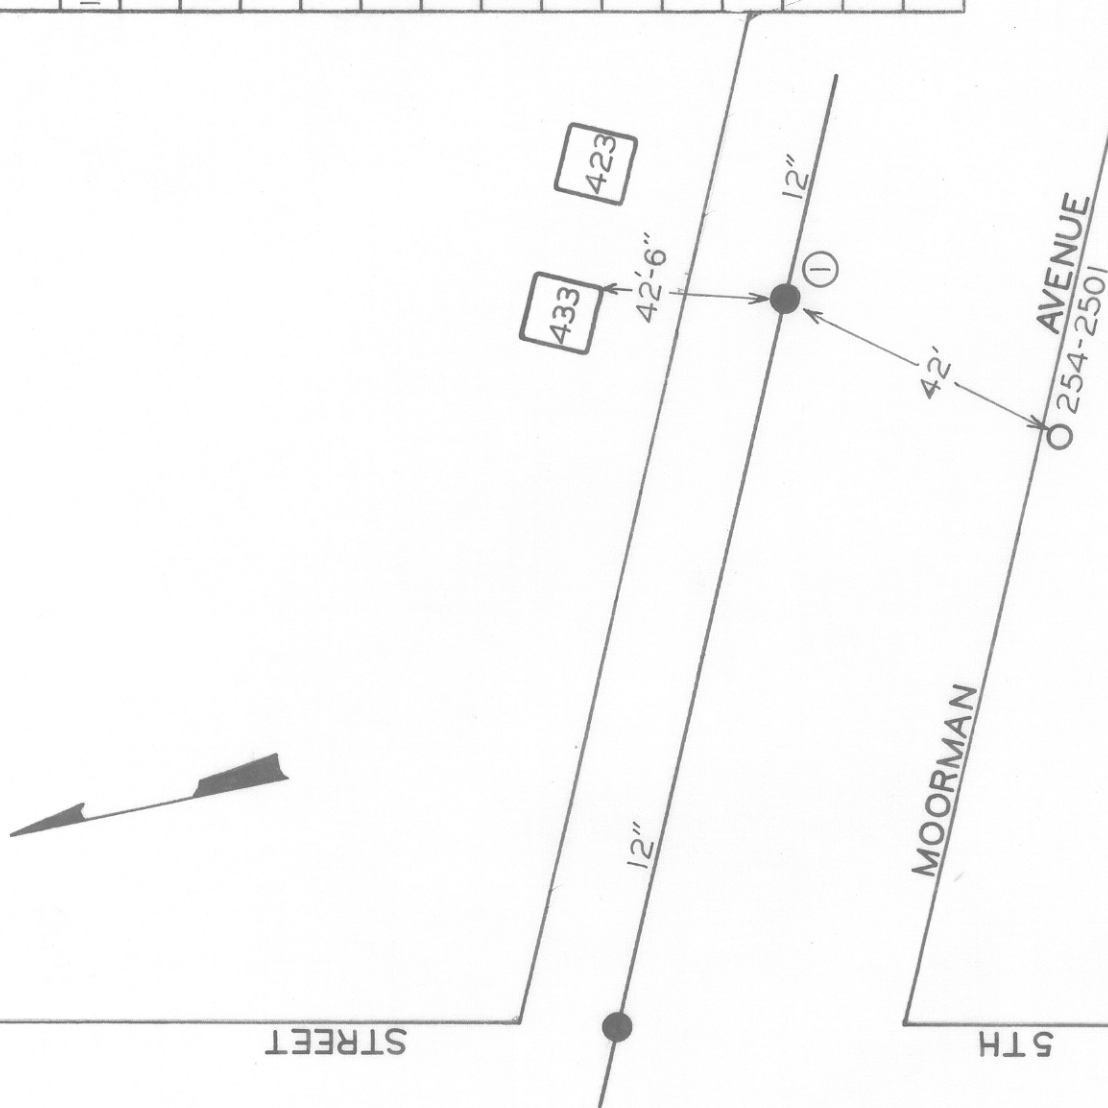


[illegible]

CITY OF ROANOKE -- WATER DEPT.	
VALVE DIAGRAM	
400 BK. MOORMAN AVENUE N.W.	
SEC. MAP 201	PAGE NO.
DATE	