


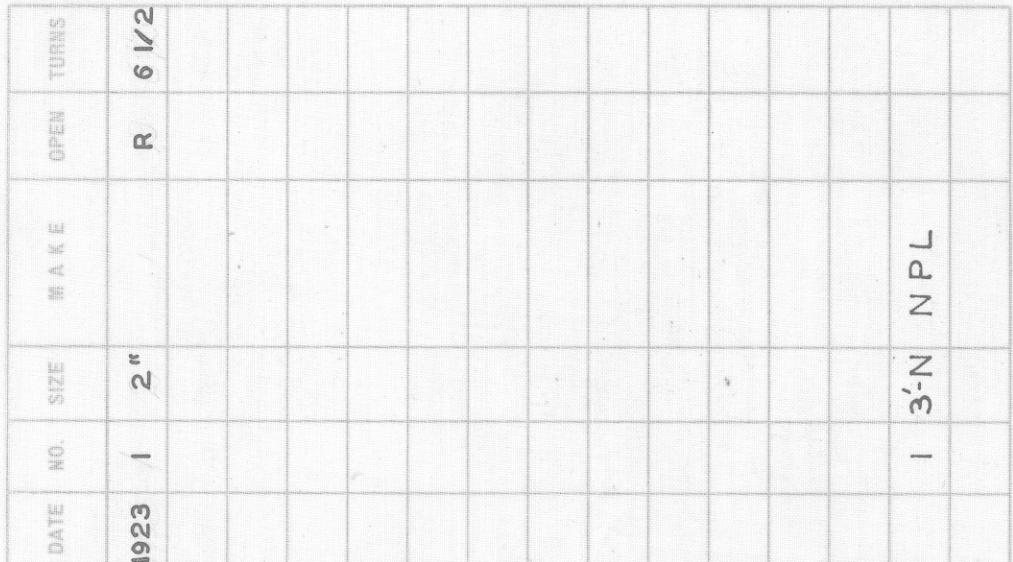

ᠠᠨᠠ

CITY OF ROANOKE—WATER DEPT					
VALVE DIAGRAM					
MOORMAN ROAD &					
10TH. ST. N. W.					
SEC. MAP	211				
DATE				PAGE NO.	NW. 100