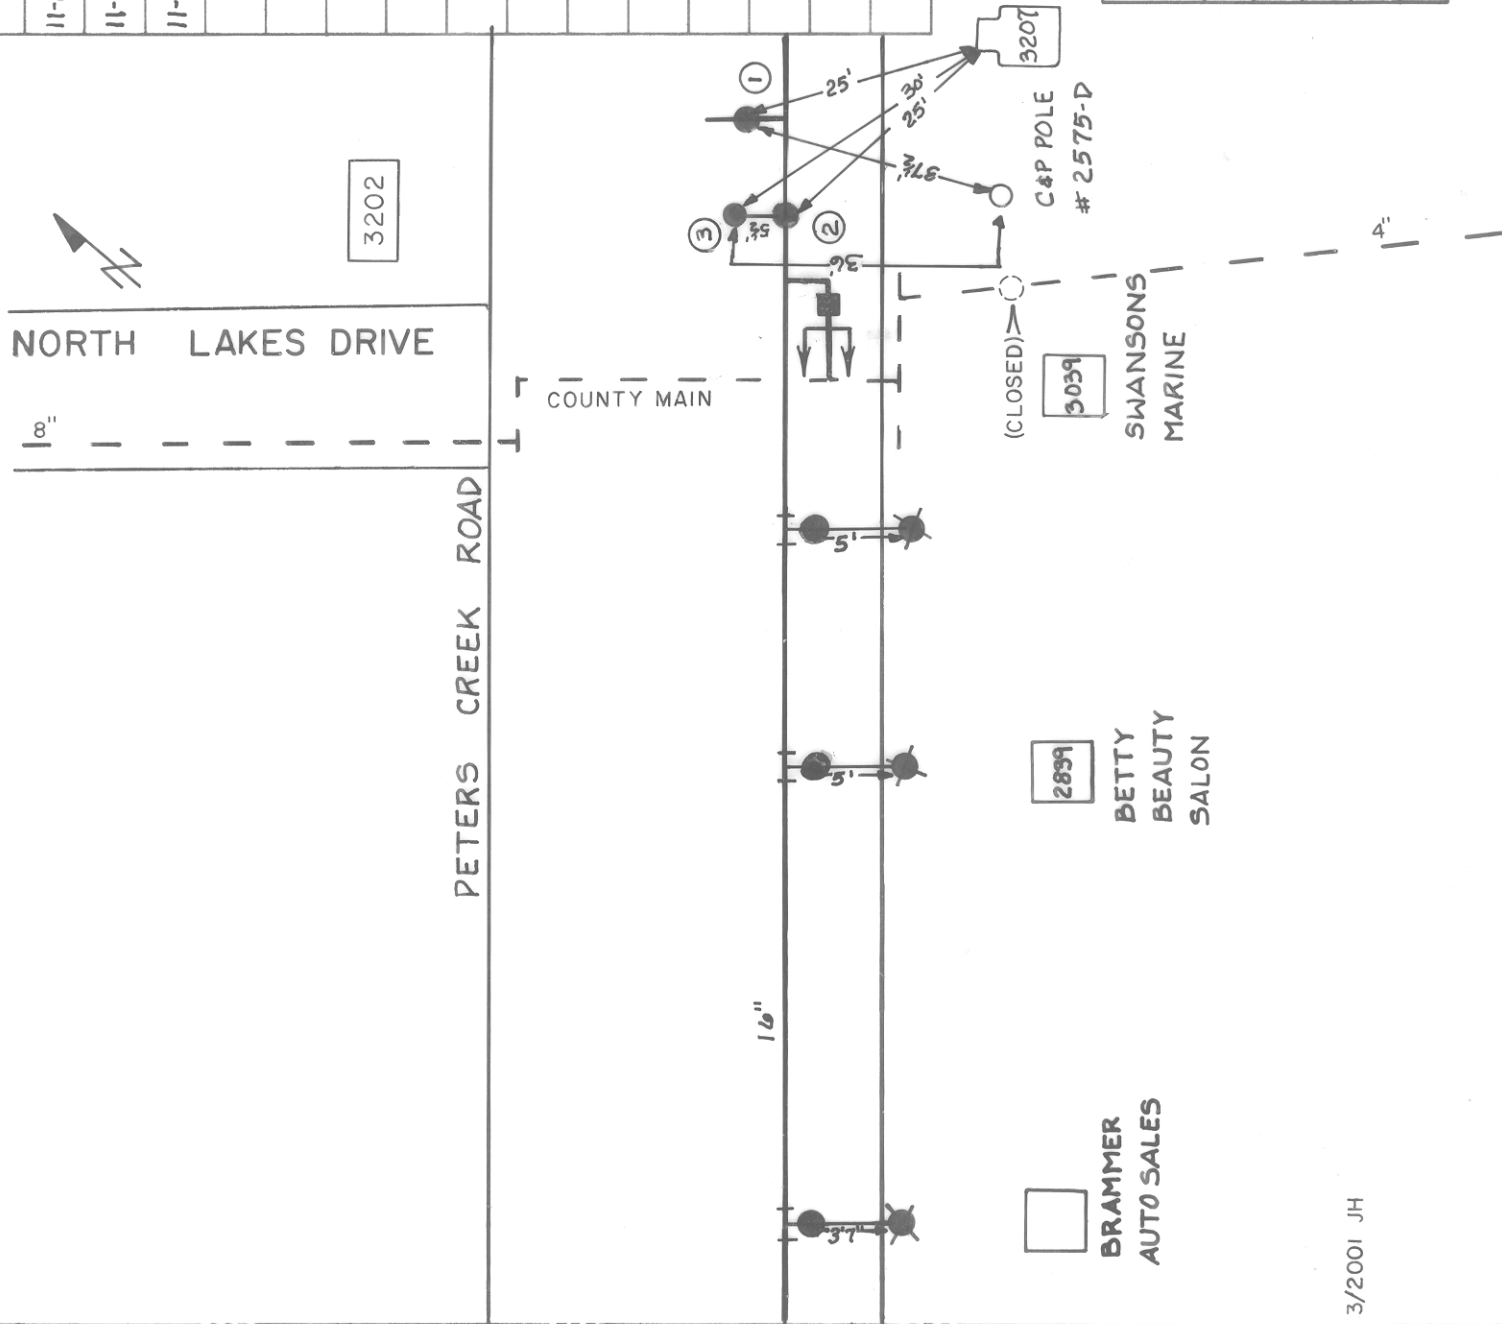


[illegible]

CITY OF ROANOKE—WATER DEPT

VALVE DIAGRAM

NORTH LAKES DRIVE 8

PETERS CREEK ROAD

SEC. MAP 642, 641 N.W.

DATE NOV. 28, 1980 PAGE NO.

3/2001 JH