


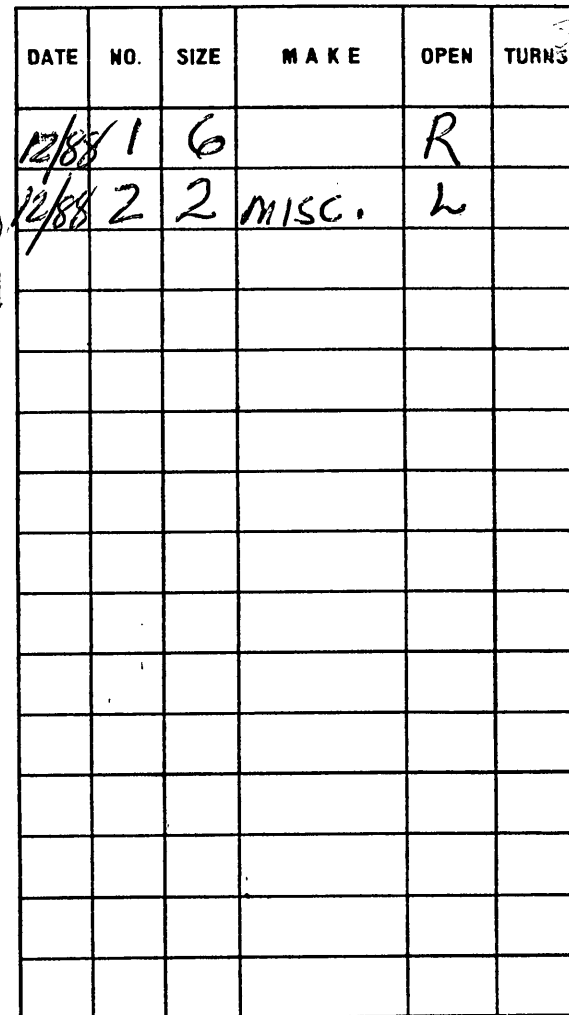

NORTH RD, NW

DATE 12-88 PAGE NO. \_\_\_\_\_