


OAKLAWN AVE.

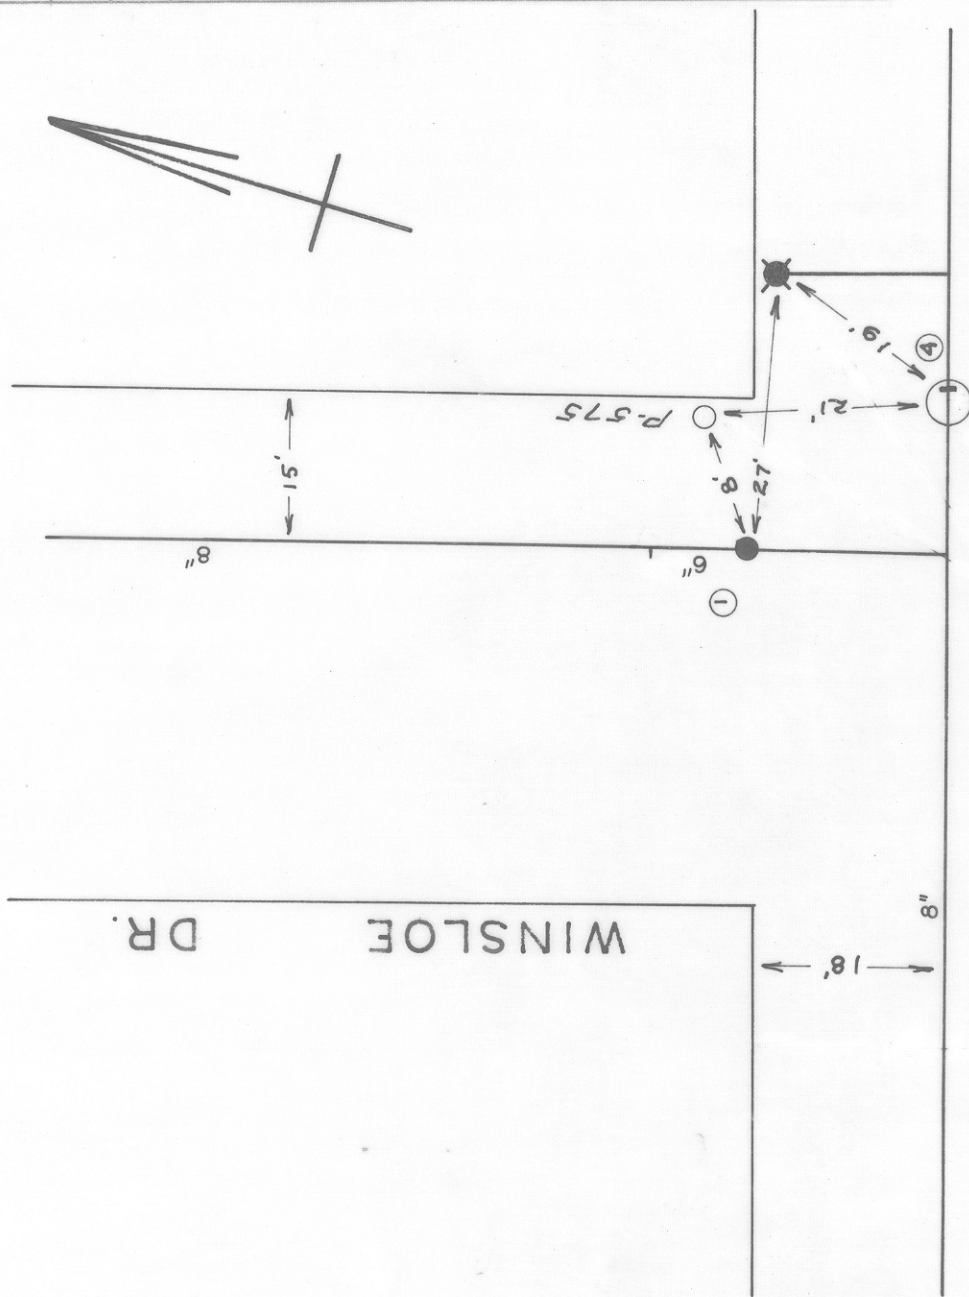

DATE	NO.	SIZE	MAKE	OPEN	TURNS
1961	1	6"			
1953	4	8"			
	1	0	NPL		
	2	15W	EPL		
	3	0	EPL		
	4	0	EPL		

CITY OF ROANOKE—WATER DEPT.

VALVE DIAGRAM

OAKLAWN AVE. &

WINSLOE DR.

EAST INTERSECTION

SEC. MAP 217 N.W.

DATE PAGE NO.