


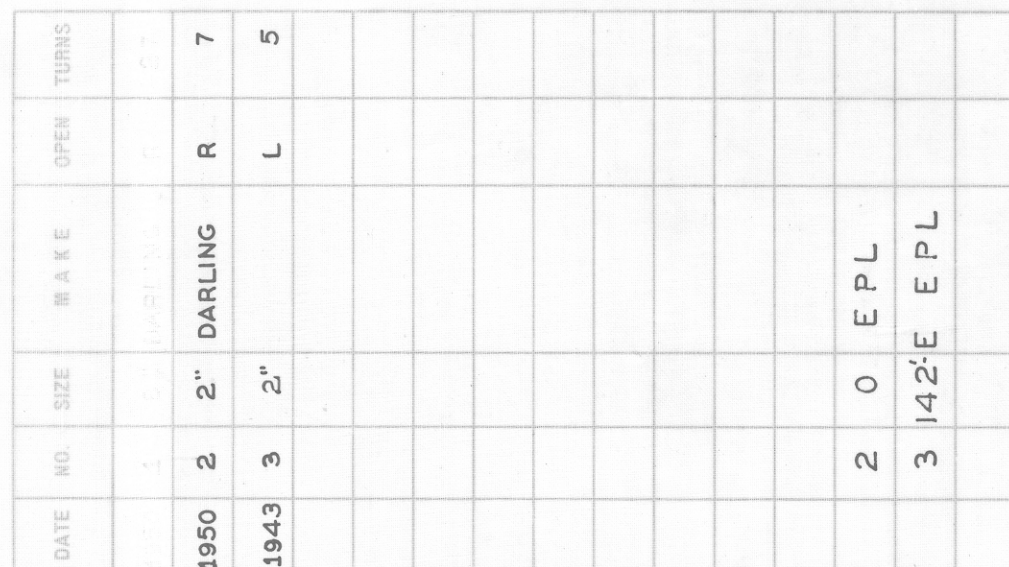

VALVE DIAGRAM

OLD COUNTRY CLUB ROAD &

SHADY LANE ROAD

SEC. MAP 254, 255 N.W.

DATE PAGE NO NW-348

2/2001 JH