


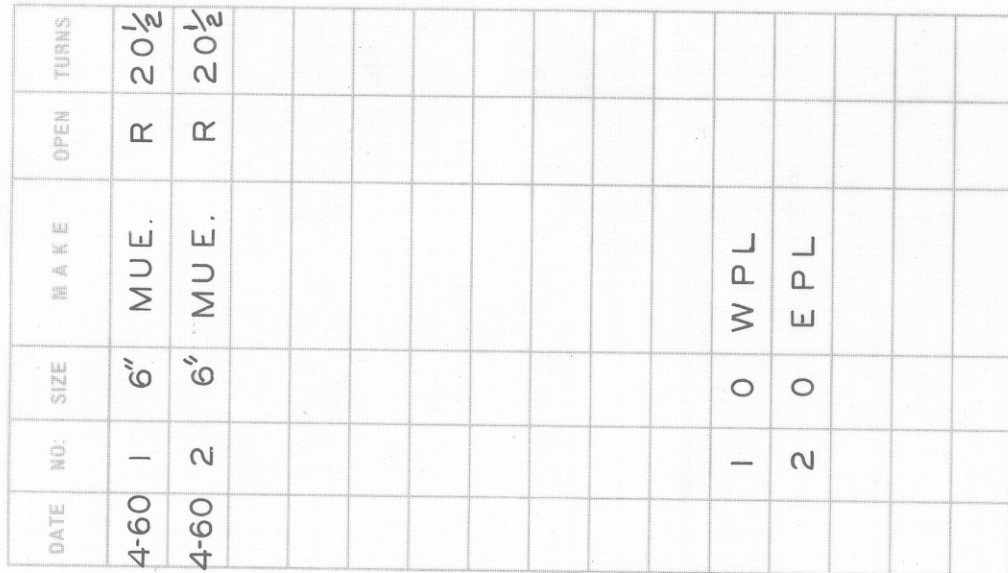

HILL AVE.

CITY OF ROANOKE—WATER DEPT
VALVE DIAGRAM

OLD STEVENS RD. &
ROLLING HILL AVE.

SEC. MAP 273
N.W.

DATE

PAGE NO.