


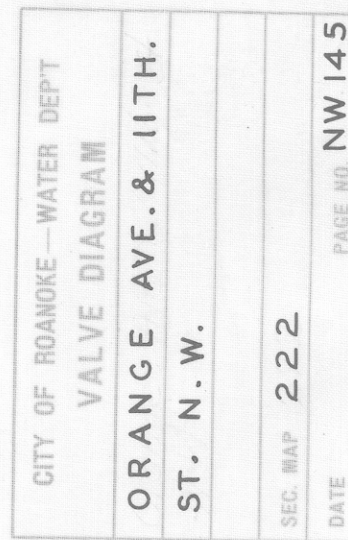

SEC. MAP 222

DATE PAGE NO. NW 145