


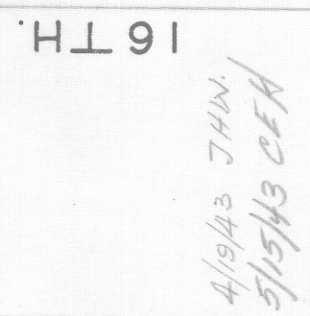

CITY OF ROANOKE—WATER DEPT
VALVE DIAGRAM
ORANGE AVE & 16TH
ST. N.W.
SEC. MAP 222
DATE
PAGE NO. N.W. 150