


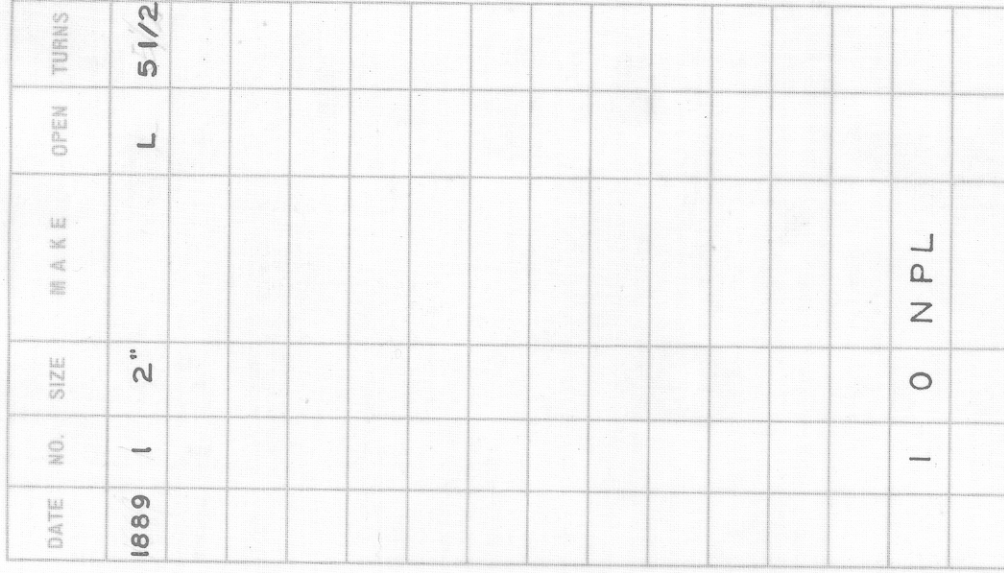

PAGE NO. NW 151

4/19/43 J.H.W.
5/15/43 C.E.H.