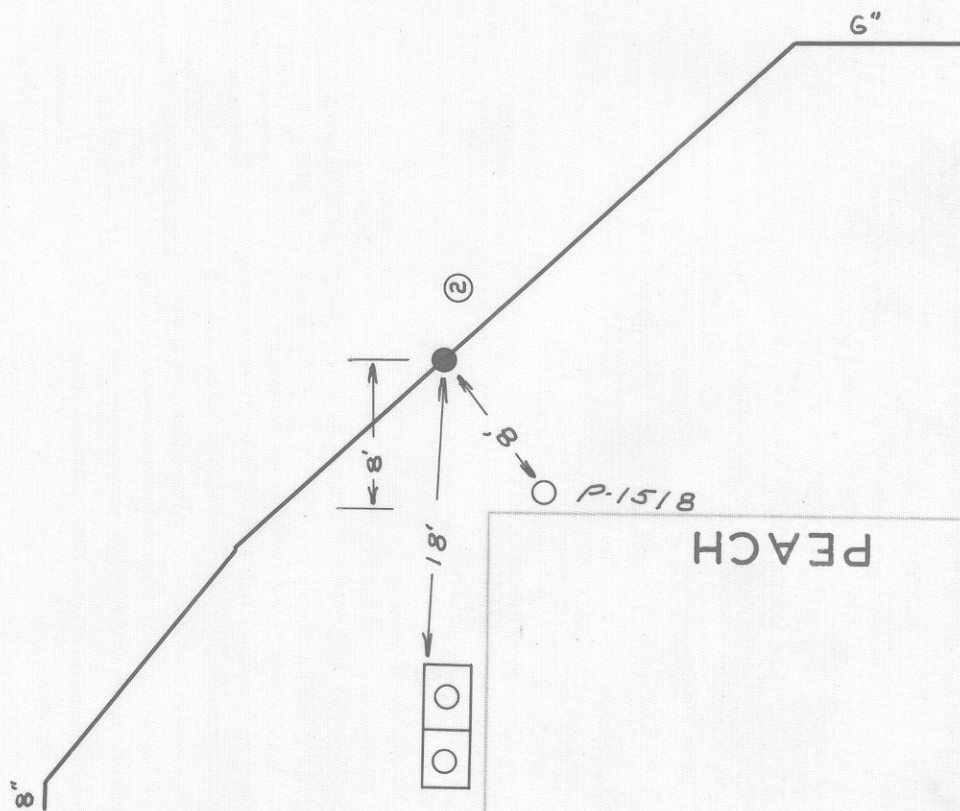
[illegible]

CITY OF ROANOKE—WATER DEPT
VALVE DIAGRAM

ORANGE AVE. & PEACH
ROAD N.W.

SEC. MAP 202

DATE . PAGE NO.