


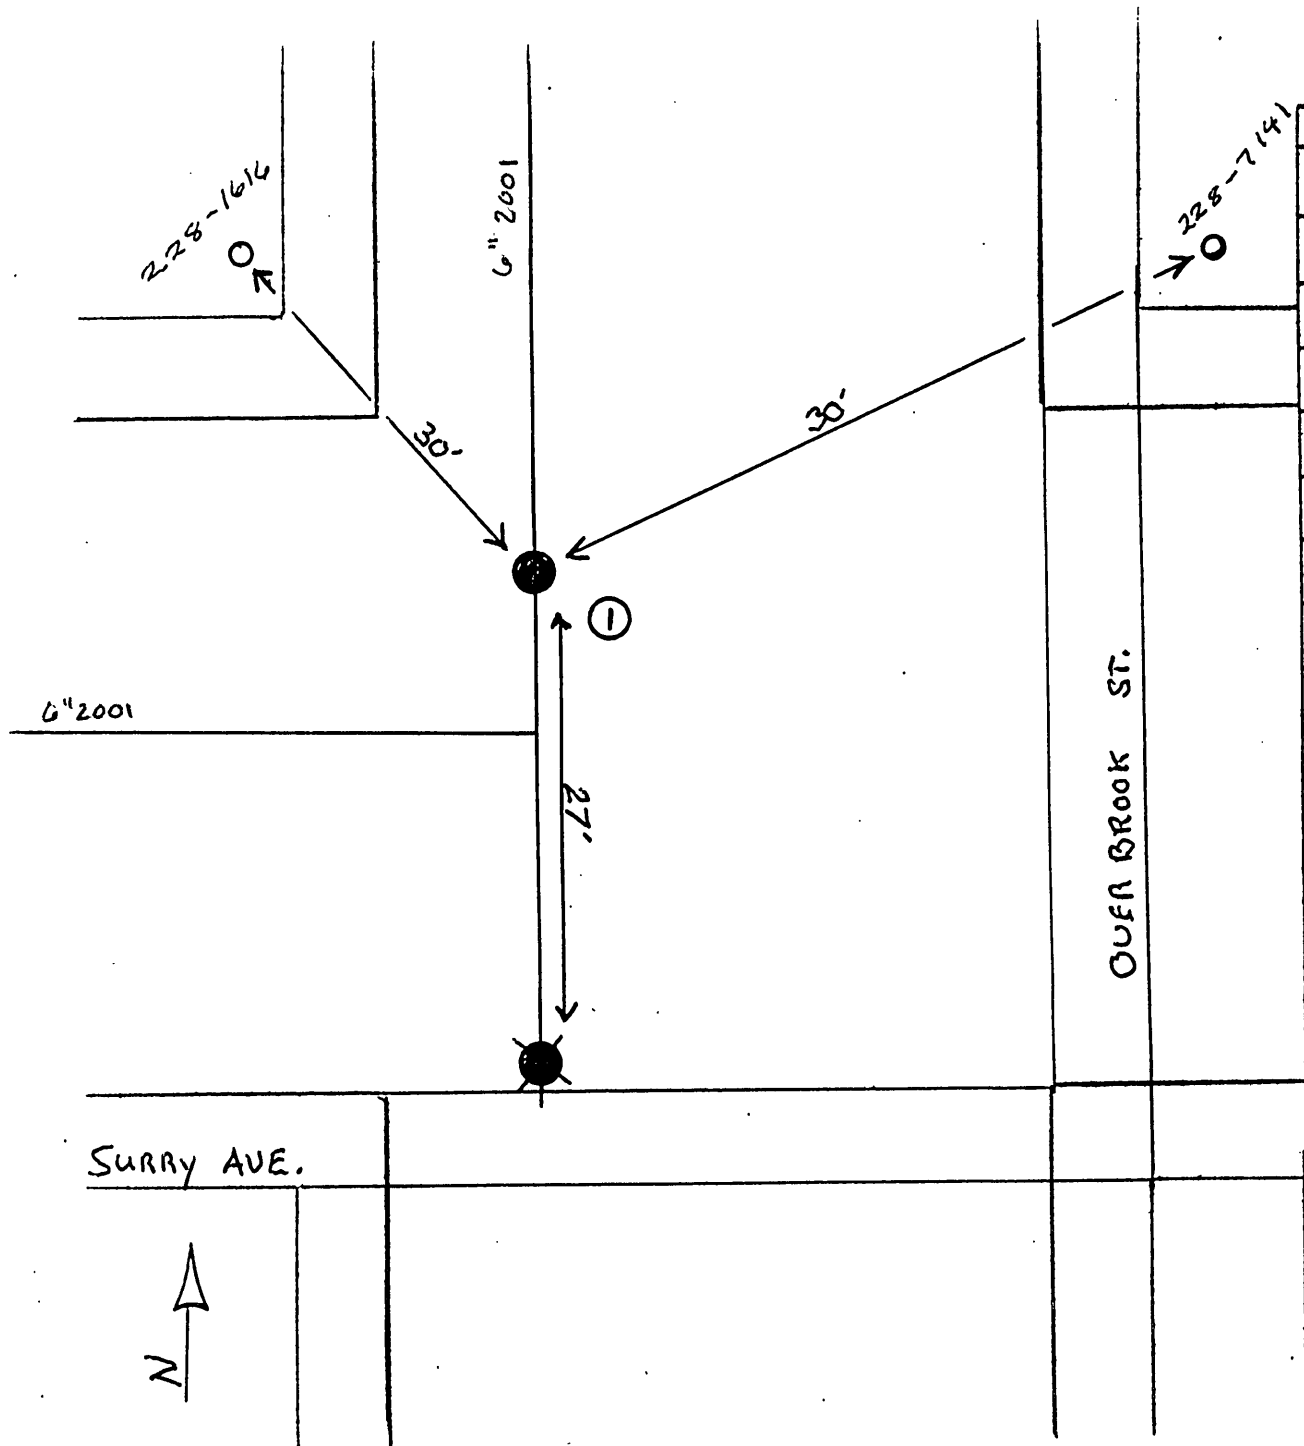

DATE	NO.	SIZE	MAKE	OPEN	TURNS
9-19-01	1	6"	AVK	R	21

P. L. Measurements		
No.	Distance	Direction

CITY OF ROANOKE - WATER DEPT.	
VALVE DIAGRAM	
Surry Ave and Overbrook St. NW	
Sec. Map 610	
Date 9-19-01	Page No.