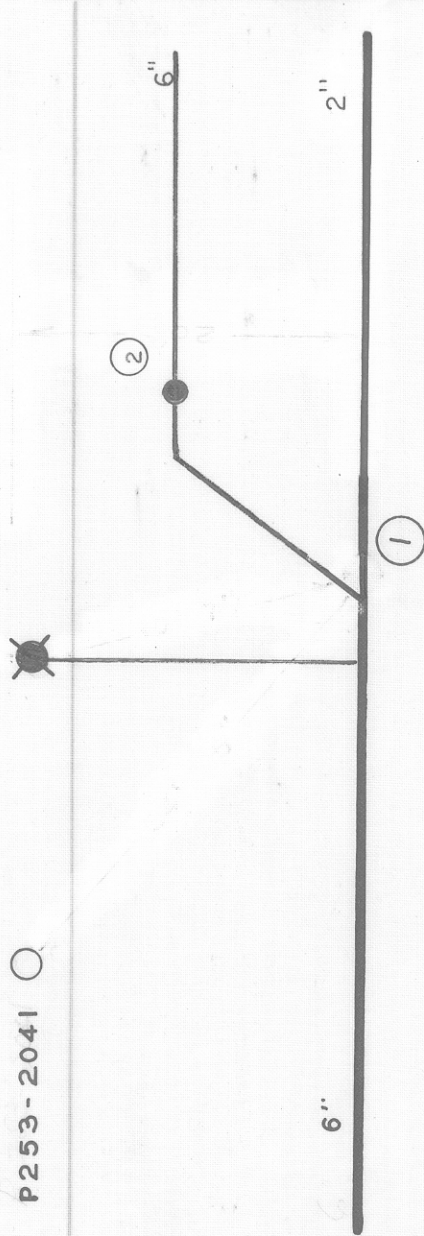


[illegible]

(PENNSYLVANIA AVE.)

2424

CITY OF ROANOKE—WATER DEPT
VALVE DIAGRAM

2412 PENNSYLVANIA
AVE. N.W.

5/8/43 J.H.W.
5/15/43 CEA
4/2001 JH

SEC. MAP 243

DATE _____

PAGE NO. NW257