


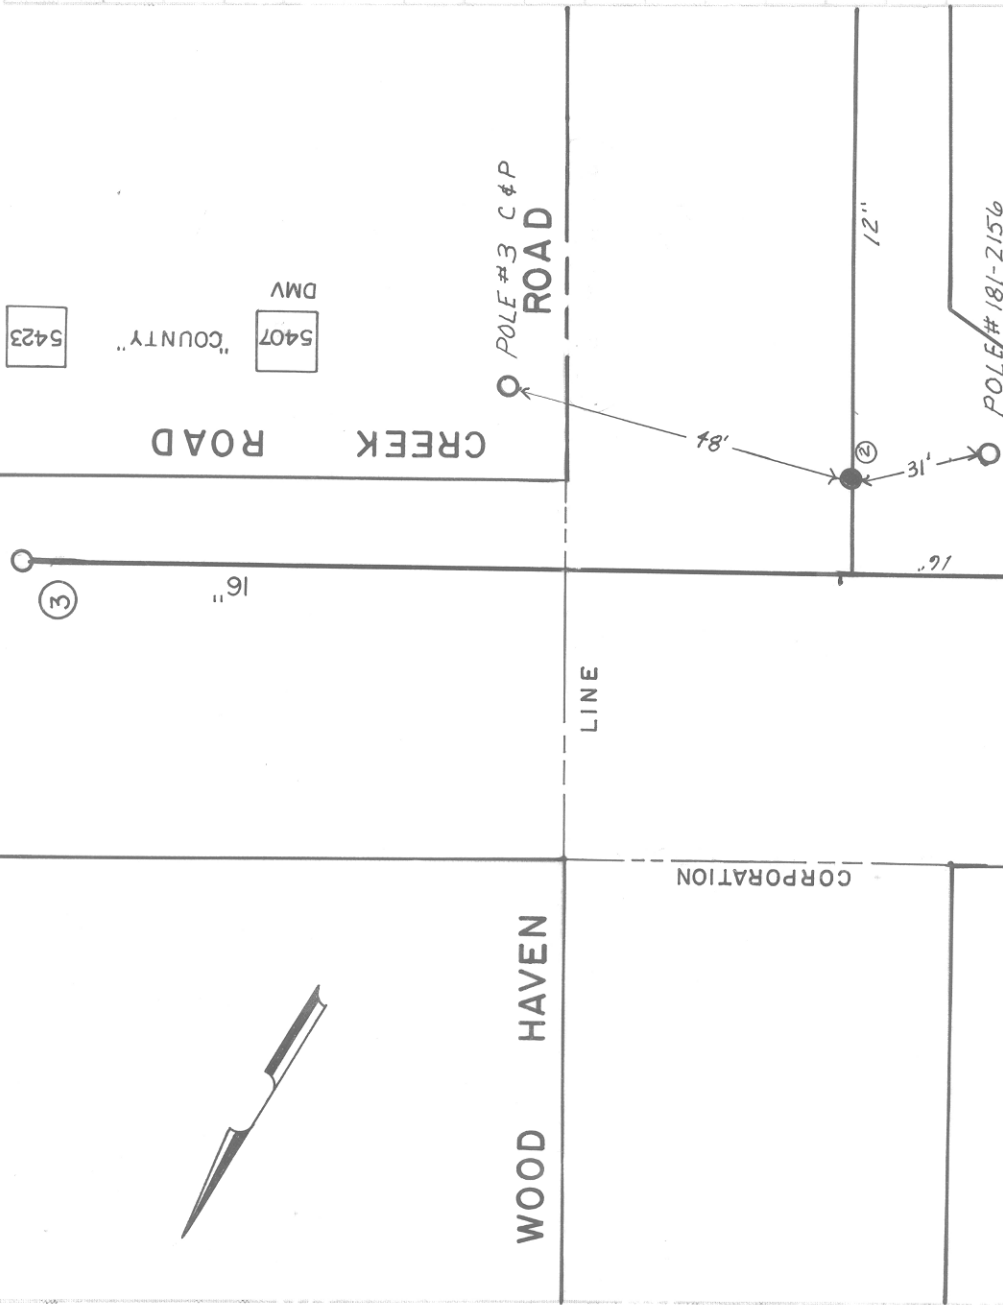

2/2001 JH