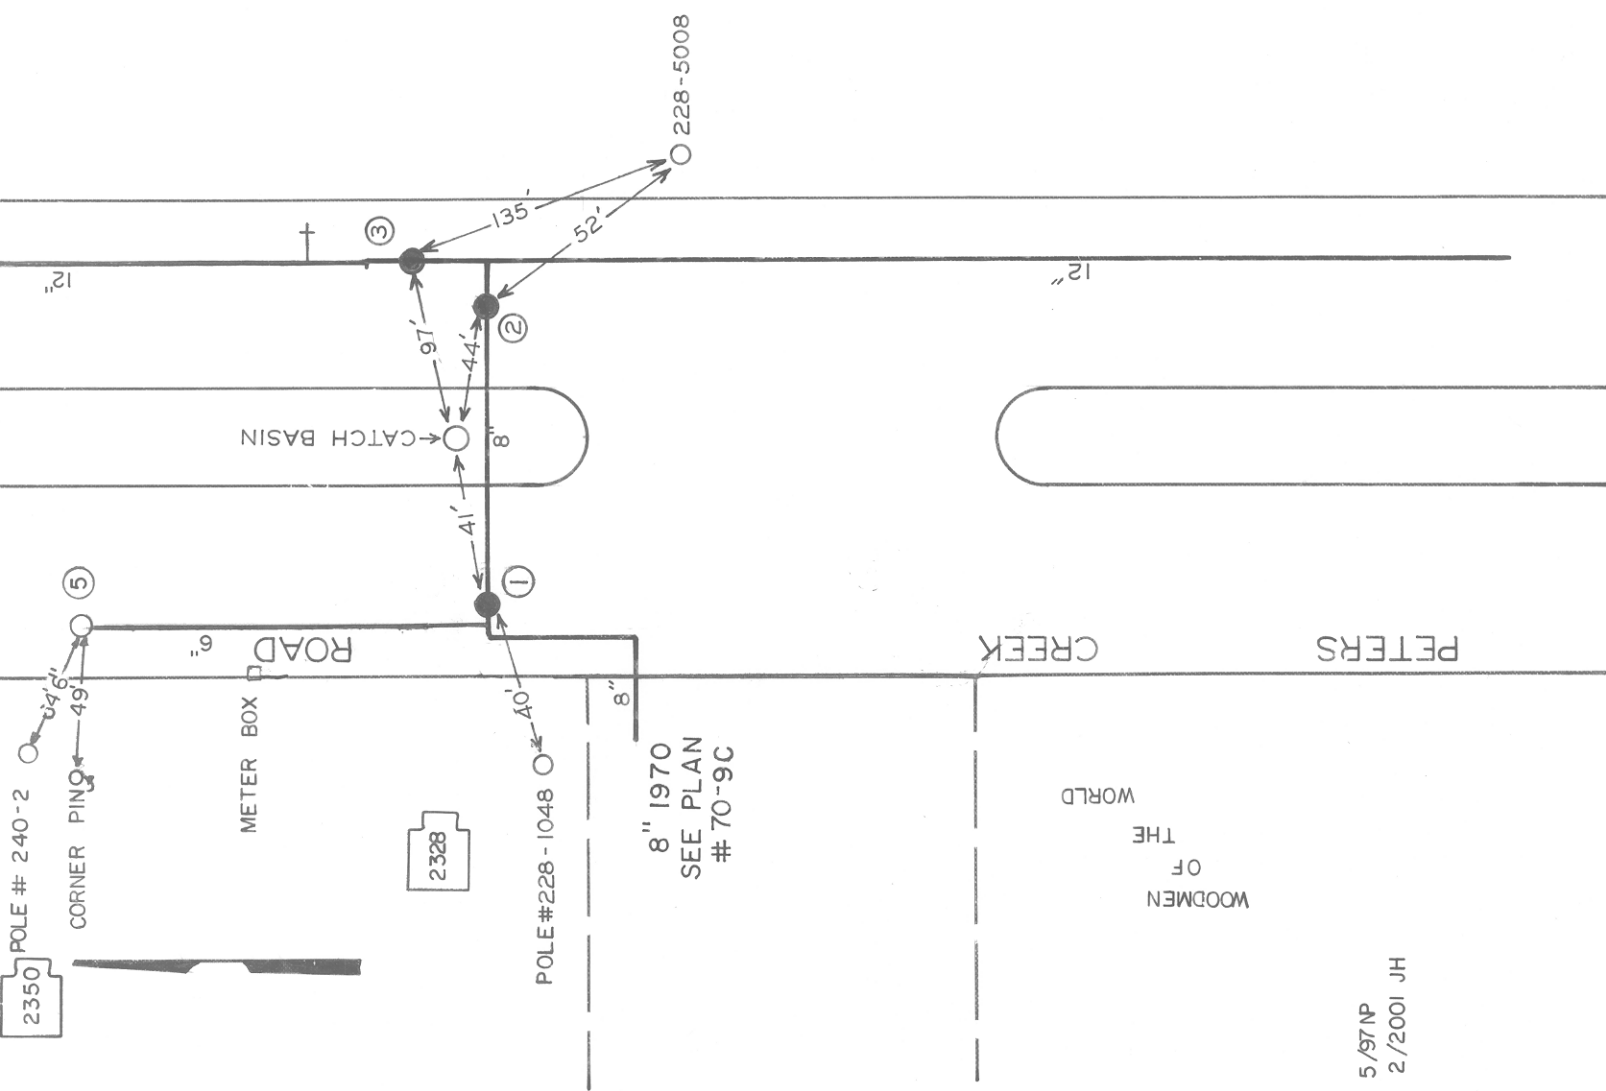


[illegible]

CITY OF ROANOKE—WATER DEPT	
VALVE DIAGRAM	
PETERS CREEK ROAD	
450' NORTH OF HARTMAN DR.	
WOODBIDGE AVE.	
SEC. MAP 616, 637	NW (2)
DATE	PAGE NO.