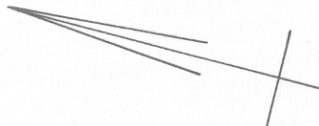


K & E CO., N. Y.

14-SPL

DATE PAGE NO.

2/2001 JH