


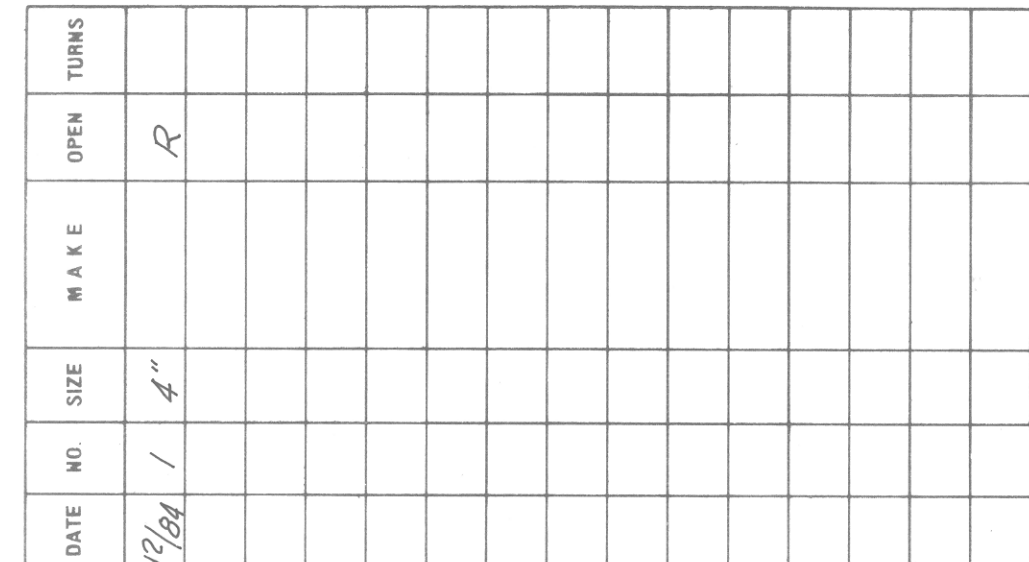

CITY OF ROANOKE—WATER DEPT
VALVE DIAGRAM
PORTLAND AVENUE
SEC. MAP
641
N.W.
DATE 4-8-85
PAGE NO.