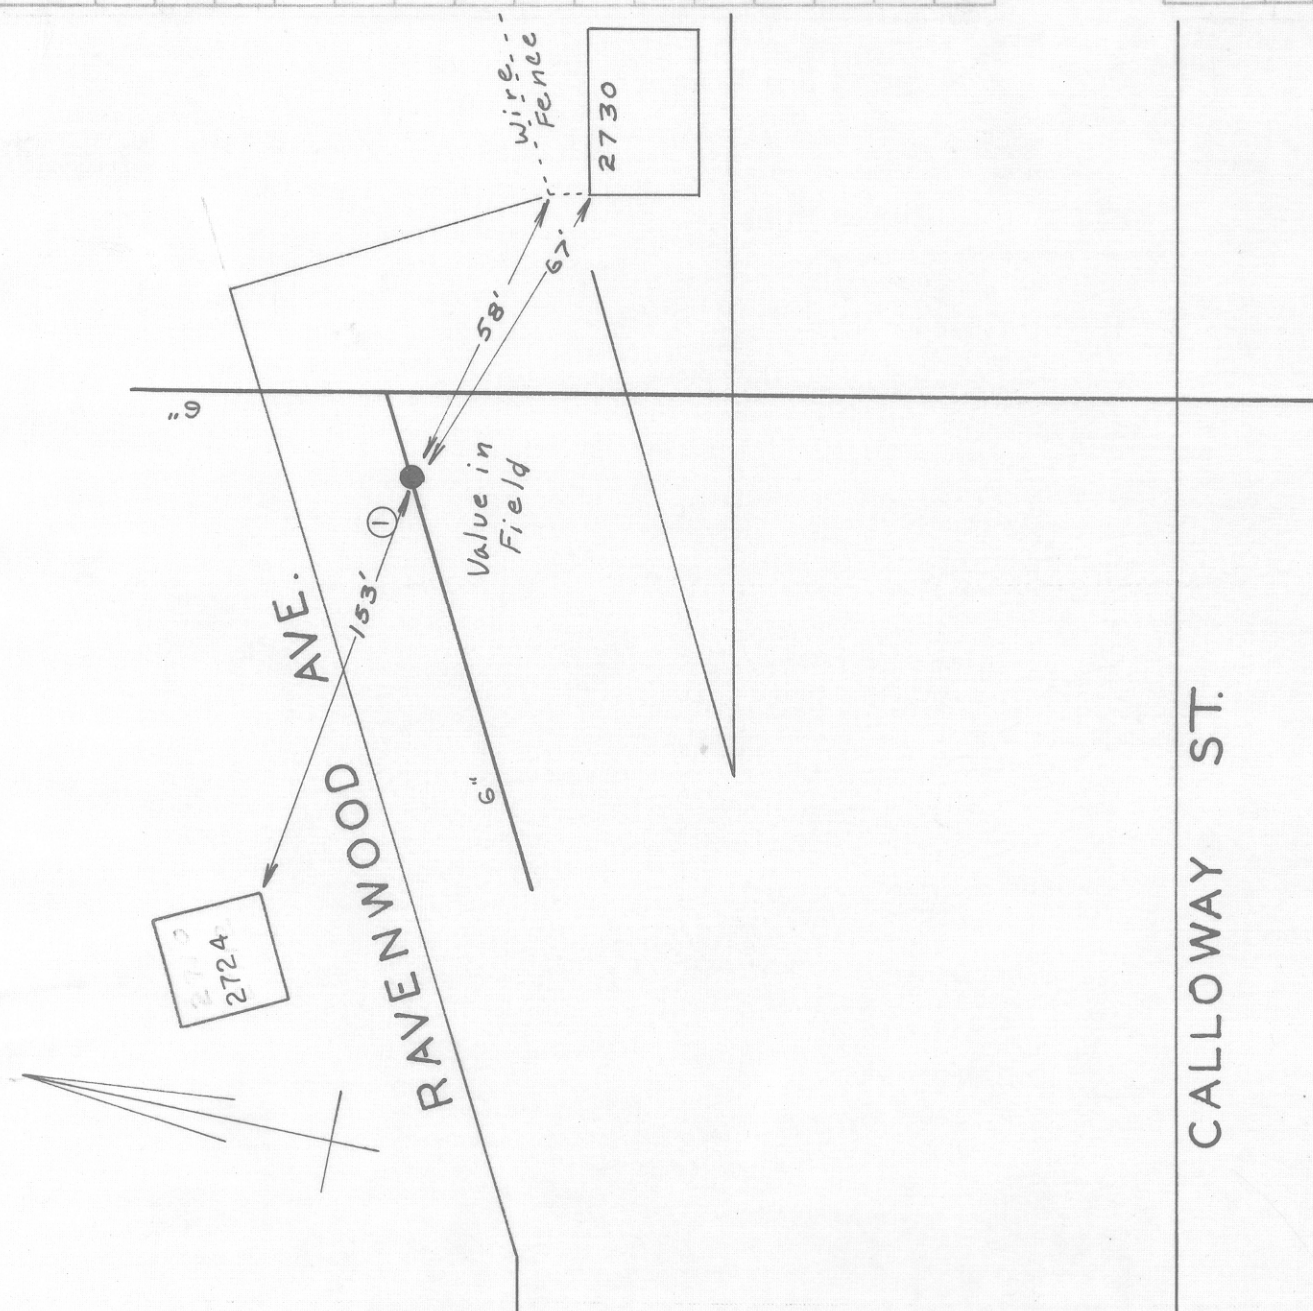


[illegible]

CALLOWAY ST.

CITY OF ROANOKE — WATER DEPT.

VALVE DIAGRAM

RAVENWOOD AVE. E. OF

GRANDVIEW AVE.

SEC. MAP 226

N.W.

DATE 10-27-67 PAGE NO. 1