


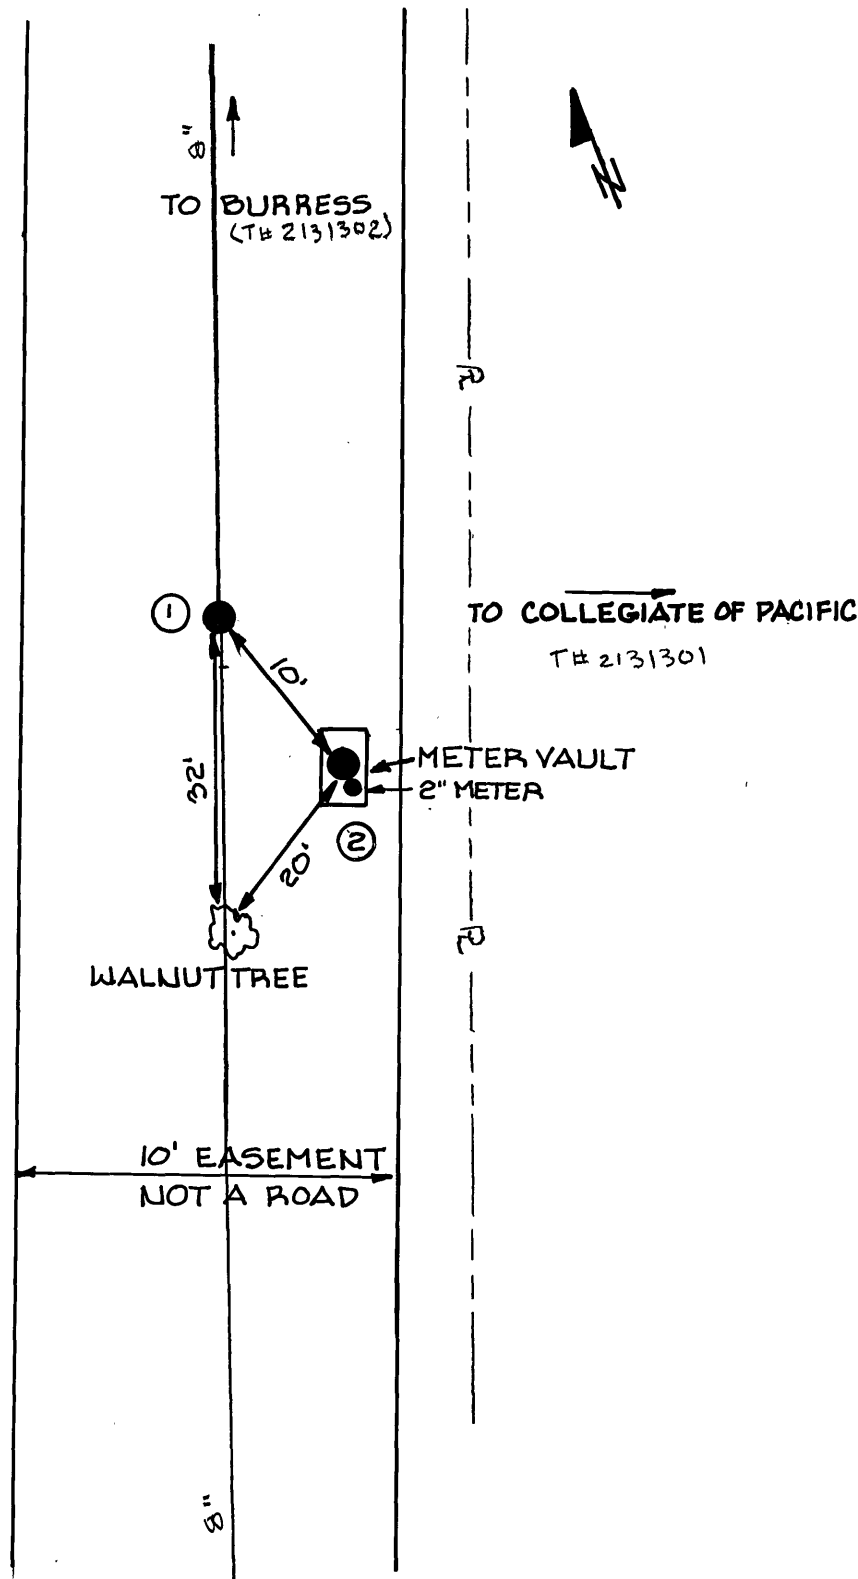

CITY OF ROANOKE—WATER DEPT	
VALVE DIAGRAM	
OFF ROCKLAND RD.	
1300 BIK	N.W.
Easement	
SEC. MAP 213	
DATE	PAGE NO.