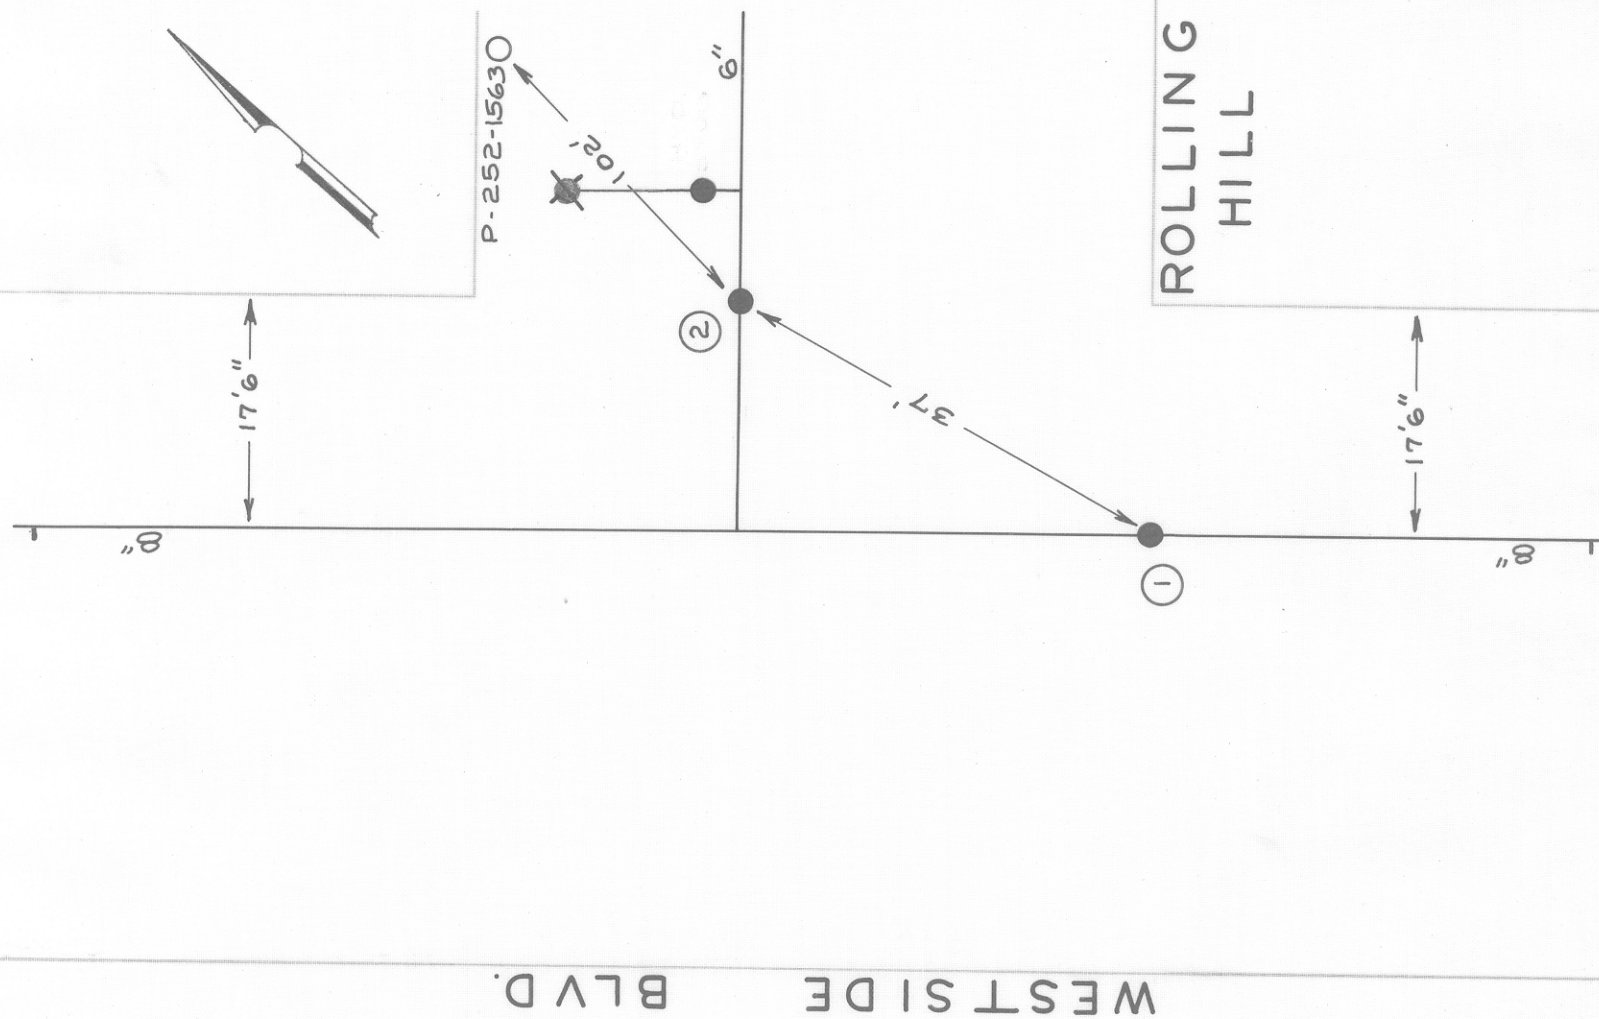


[illegible]

CITY OF ROANOKE—WATER DEPT
VALVE DIAGRAM
ROLLING HILL AVE. & WESTSIDE BLVD. N.W.
SEC. MAP 273
N.W.
DATE
PAGE NO.