


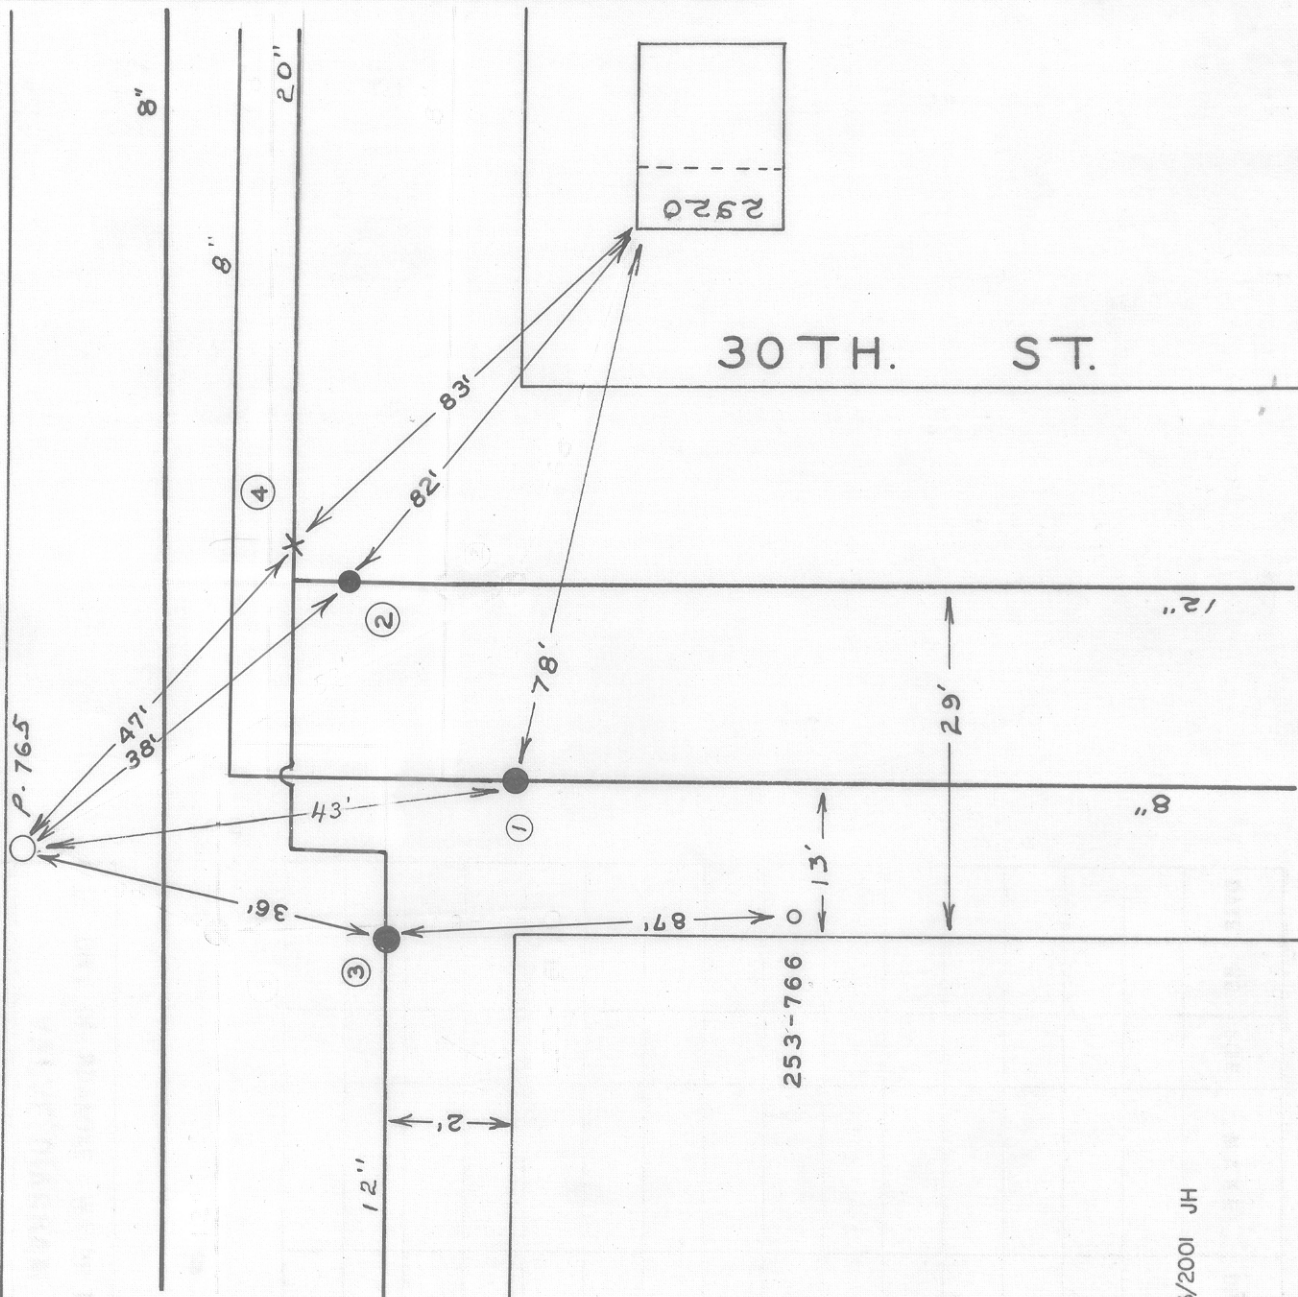

CITY OF ROANOKE -- WATER DEPT.					
VALVE DIAGRAM					
SALEM TURNPIKE &					
30 TH. ST.					
EAST INTERSECTION					
SEC. MAP	253	252		N.W.	
DATE				PAGE NO.	