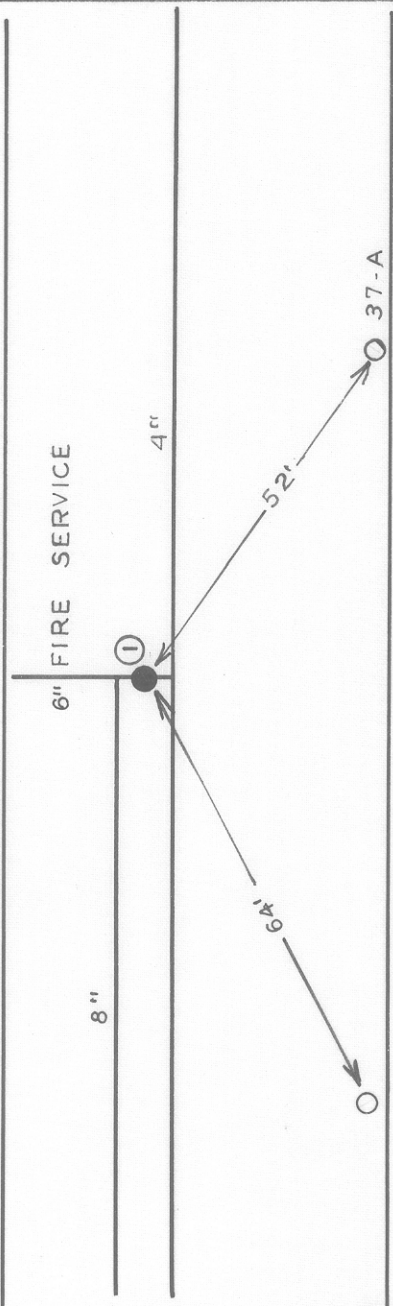


[illegible]

CITY OF ROANOKE -- WATER DEPT.

VALVE DIAGRAM

200 BLOCK SHENANDOAH

AVENUE N.W.

SEC. MAP 201

DATE PAGE NO.