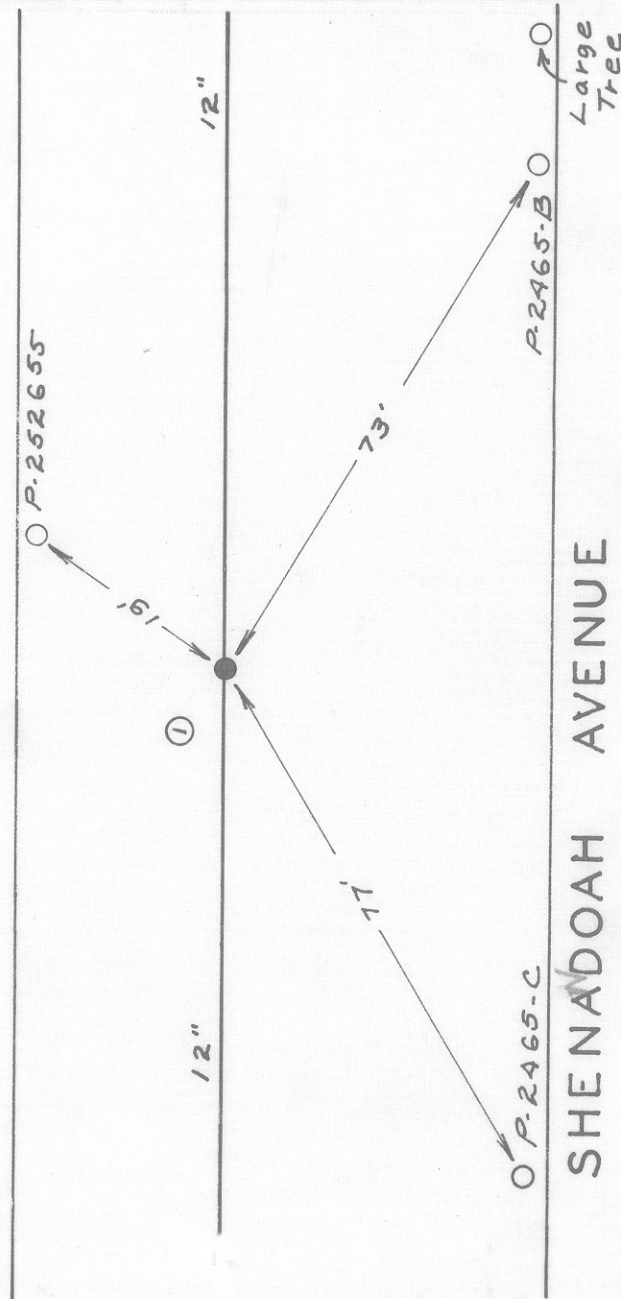
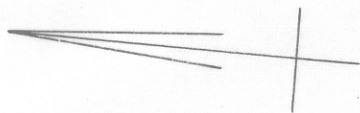


[illegible]

CITY OF ROANOKE — WATER DEPT.

VALVE DIAGRAM

SHENADOAH AVE. WEST
OF CLUB CHEROKEE

SEC. MAP 40

DATE PAGE NO.

Salem, Va.?