


P253-7056 Q SHENANDOAH AVE.

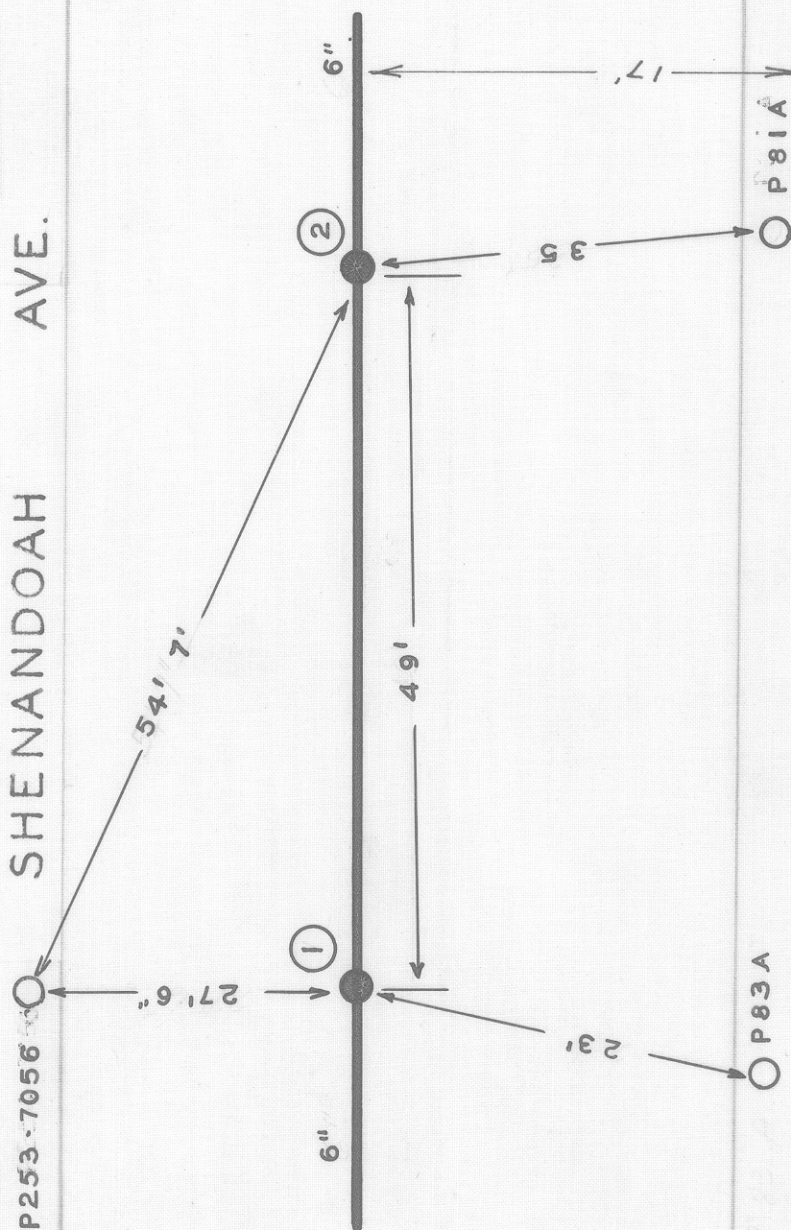

1	414-E EPL AT 14TH ST.
2	403'-EEPL AT 14TH ST.

CITY OF ROANOKE—WATER DEPT

VALVE DIAGRAM

SHENANDOAH AVE.

BETWEEN 12 & 14 TH ST.

221
SEC. MAP

DATE _____

PAGE NO. N.W. 113

5/15/43 CEF

3/2001 JH