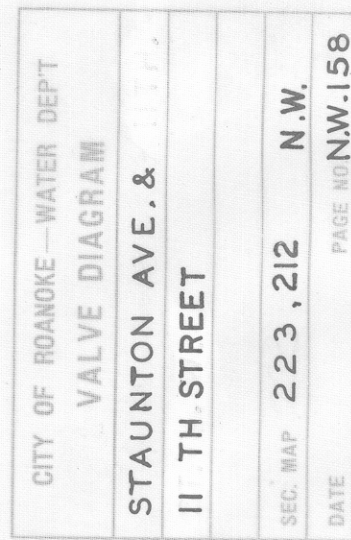


[illegible]

4/20/43 J.H.W.
5/15/43 C.E.H.
3/2001 JH