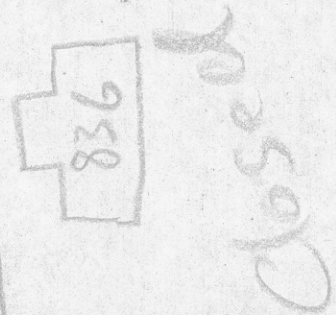


[illegible]

CITY OF ROANOKE—WATER DEPT
VALVE DIAGRAM
STAUNTON AVE. & 9TH.
ST. N. W.
SEC. MAP 203 213
DATE PAGE NO. N.W. 59