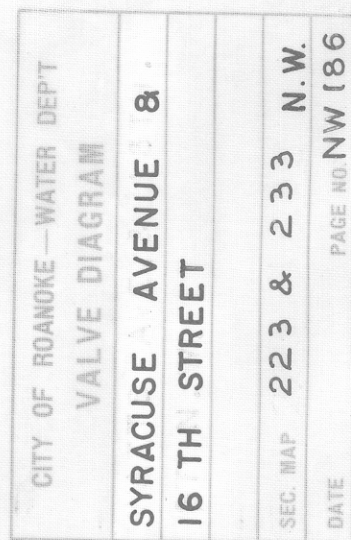


[illegible]

4/27/43 J. H. W.
5/15/43 C. E. H.