


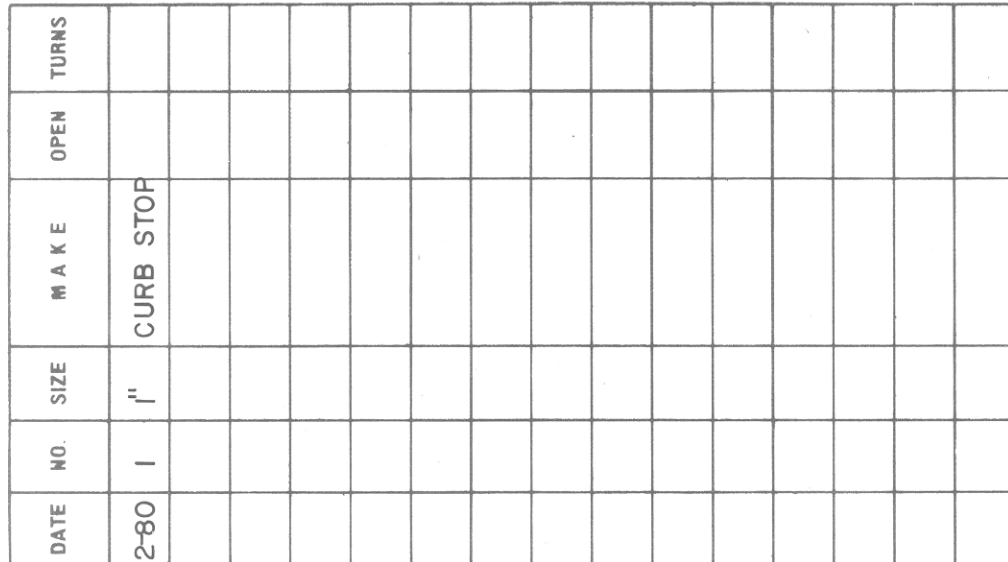

SYRACUSE AVE.

1/87 NP

CITY OF ROANOKE—WATER DEPT

VALVE DIAGRAM

1031 SYRACUSE AVENUE

NW

SEC. MAP 213, 223

DATE **PAGE NO.**