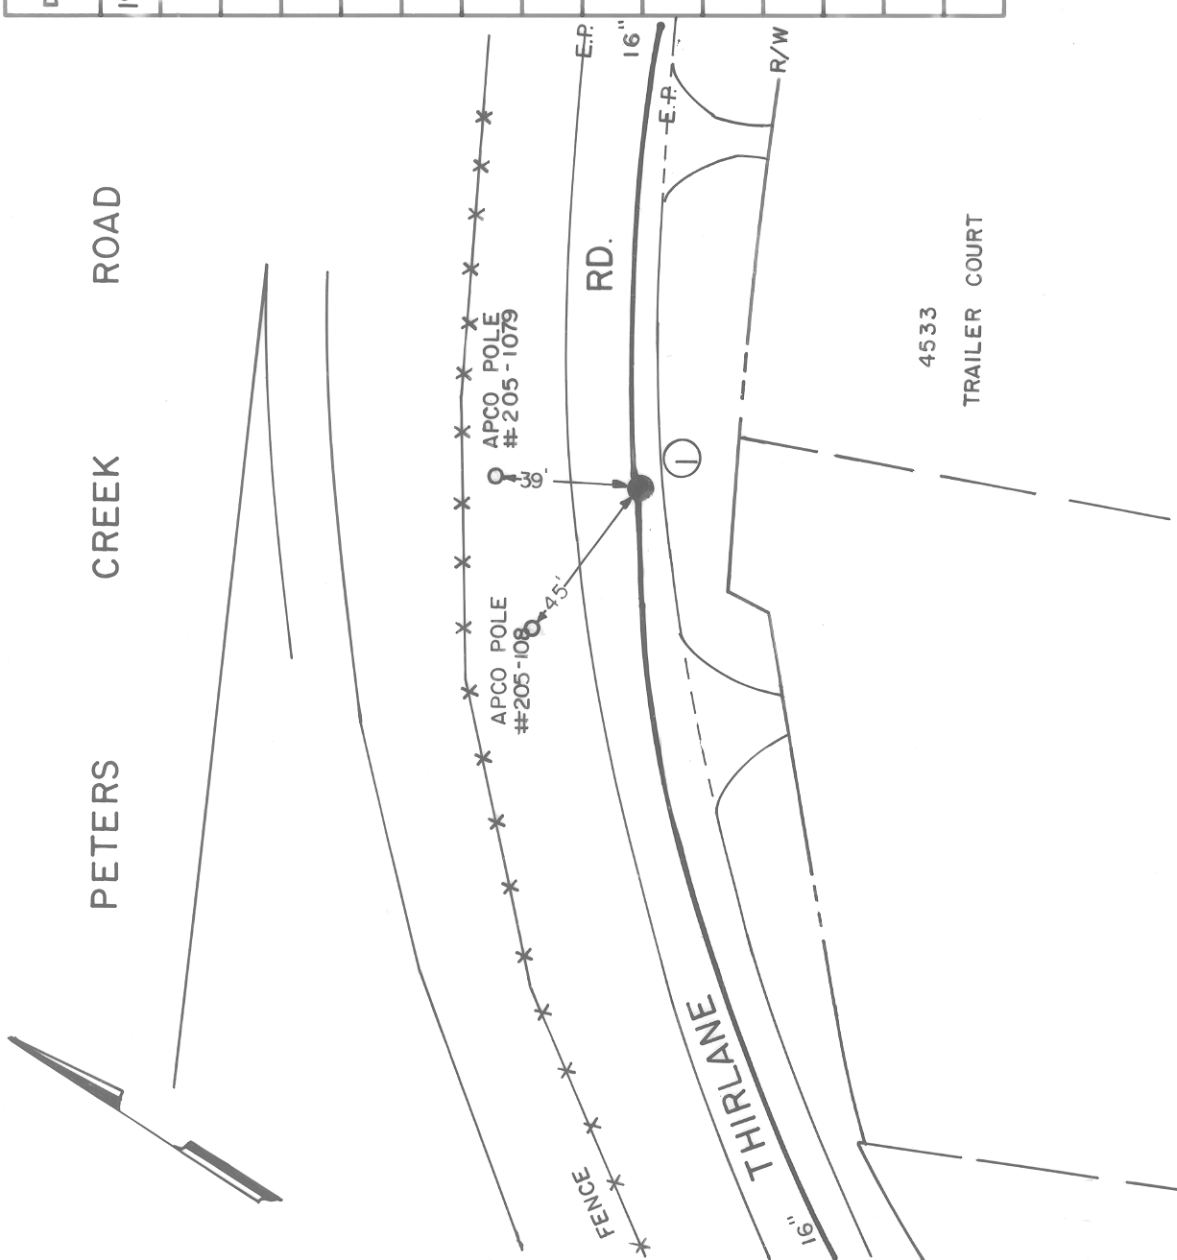


[illegible]

VALVE DIAGRAM

4500 BLOCK

N.W.

PAGE NO.