
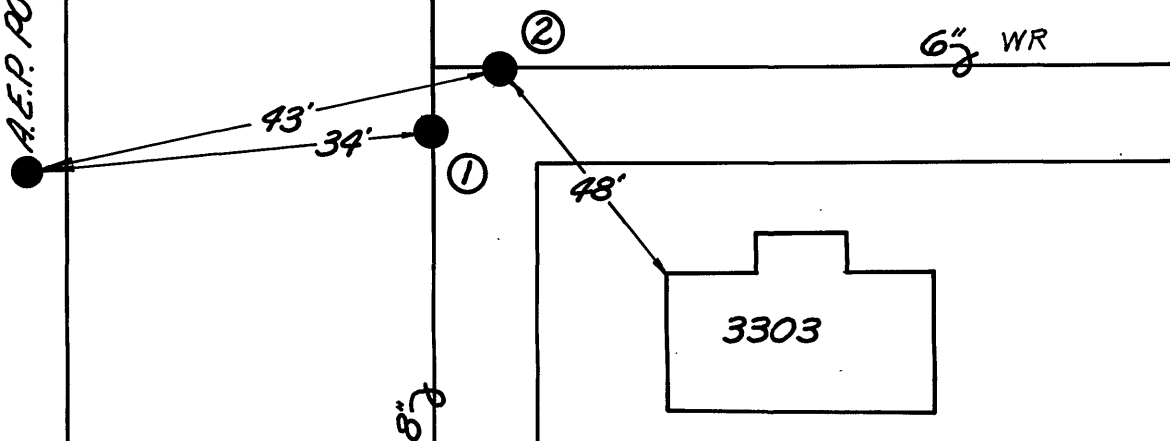


WINSLOE DR.

THURMAN AVE. N.W.

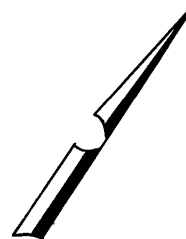

3303

8/2000 JH

[illegible]

CITY OF HOUSTON - DISTRICT 11
VALLEY DIAGRAM

THURMAN AVE. &
WINSLOE DRIVE

SEC. 217 N. W.
DAVIS