
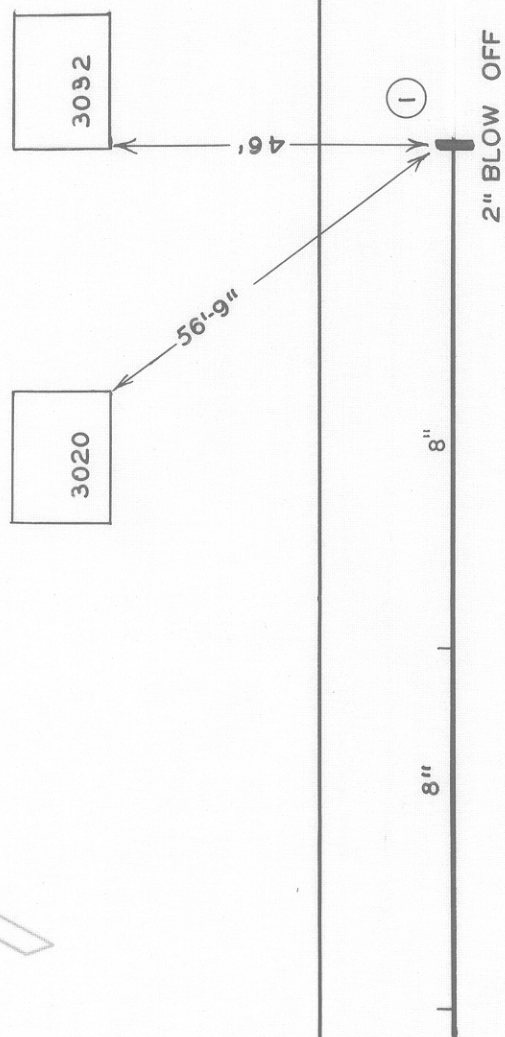


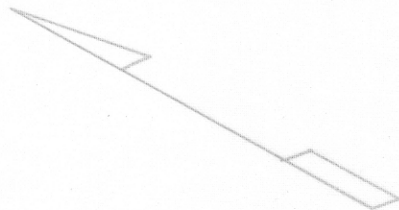

TRINKLE AVENUE

[illegible]

CITY OF ROANOKE — WATER DEPT.

## VALVE DIAGRAM

3032 TRINKLE AVENUE

SEC. MAP 210, 209 N.W.

DATE