


WEST SIDE BLVD.

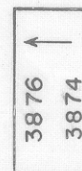

CITY OF ROANOKE -- WATER DEPT.	
VALVE DIAGRAM	
WEST SIDE BLVD. &	
WOODLEIGH RD.	
SEC. MAP 275	N.W.
DATE	PAGE NO.