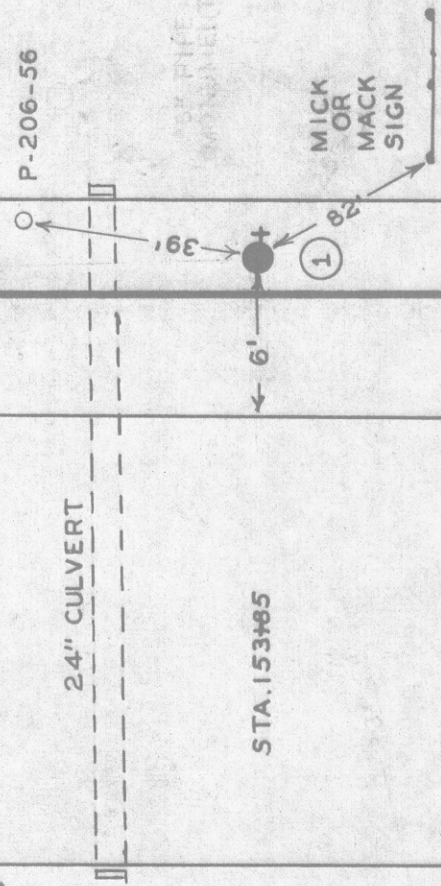


[illegible]

CITY OF ROANOKE—WATER DEPT
VALVE DIAGRAM

WILLIAMSON RD. 2289' N
OF AIR VALVE ON N.S.OF
HERSHBERGER & WILLIAMSON

SEC. MAP

DATE _____

PAGE NO. ~~NE 123~~