


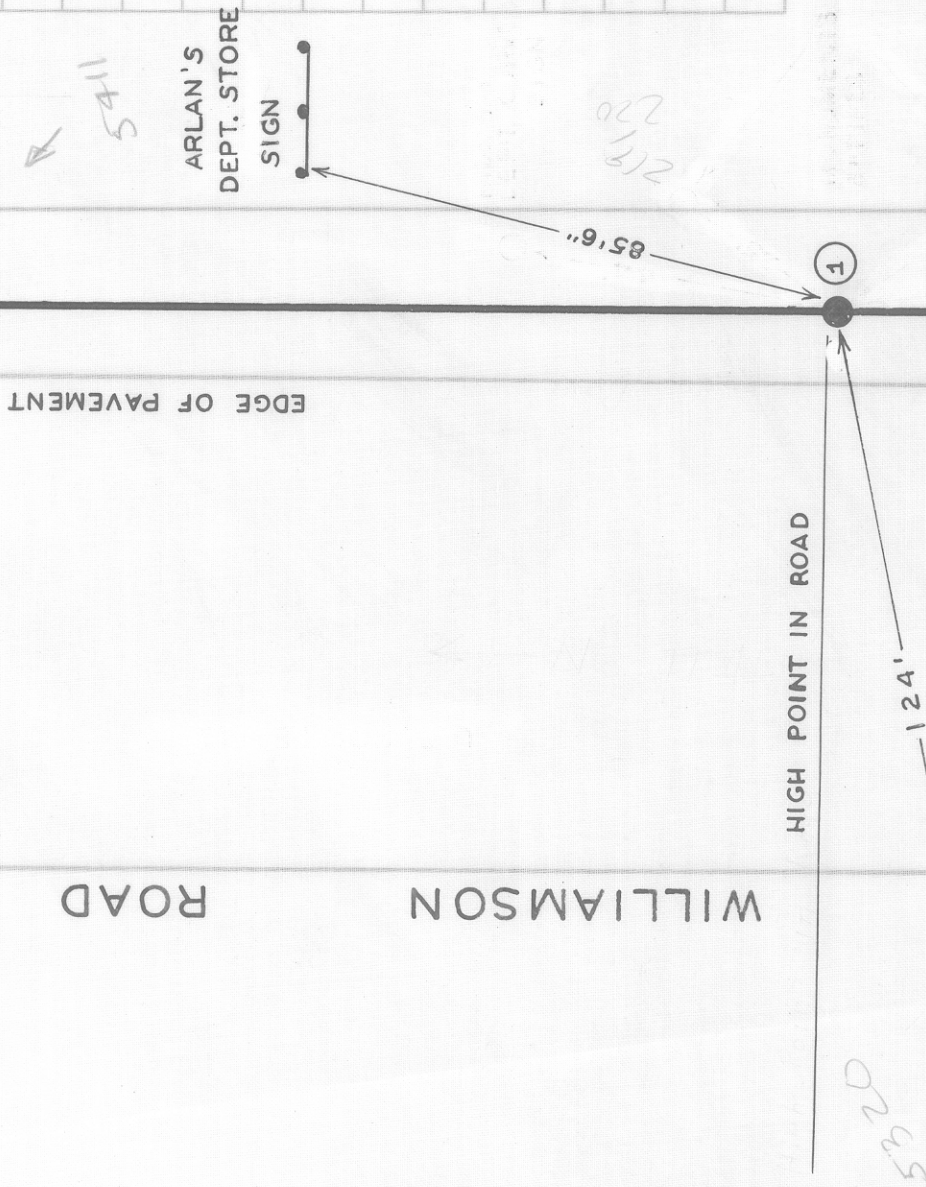

CITY OF ROANOKE — WATER DEPT	VALVE DIAGRAM	WILLIAMSON RD. 2882' N.	OF AIR VALVE ON N S OF	HERSHBERGER & WILLIAMSON	ROADS	SEC. MAP	DATE	PAGE NO.	NE 124
------------------------------	---------------	-------------------------	------------------------	--------------------------	-------	----------	------	----------	--------