


DATE	NO.	SIZE	MAKE	OPEN	URNS
'58	1	8"	DARLING	R	28

I 34'-E WPL

541

36TH STREET

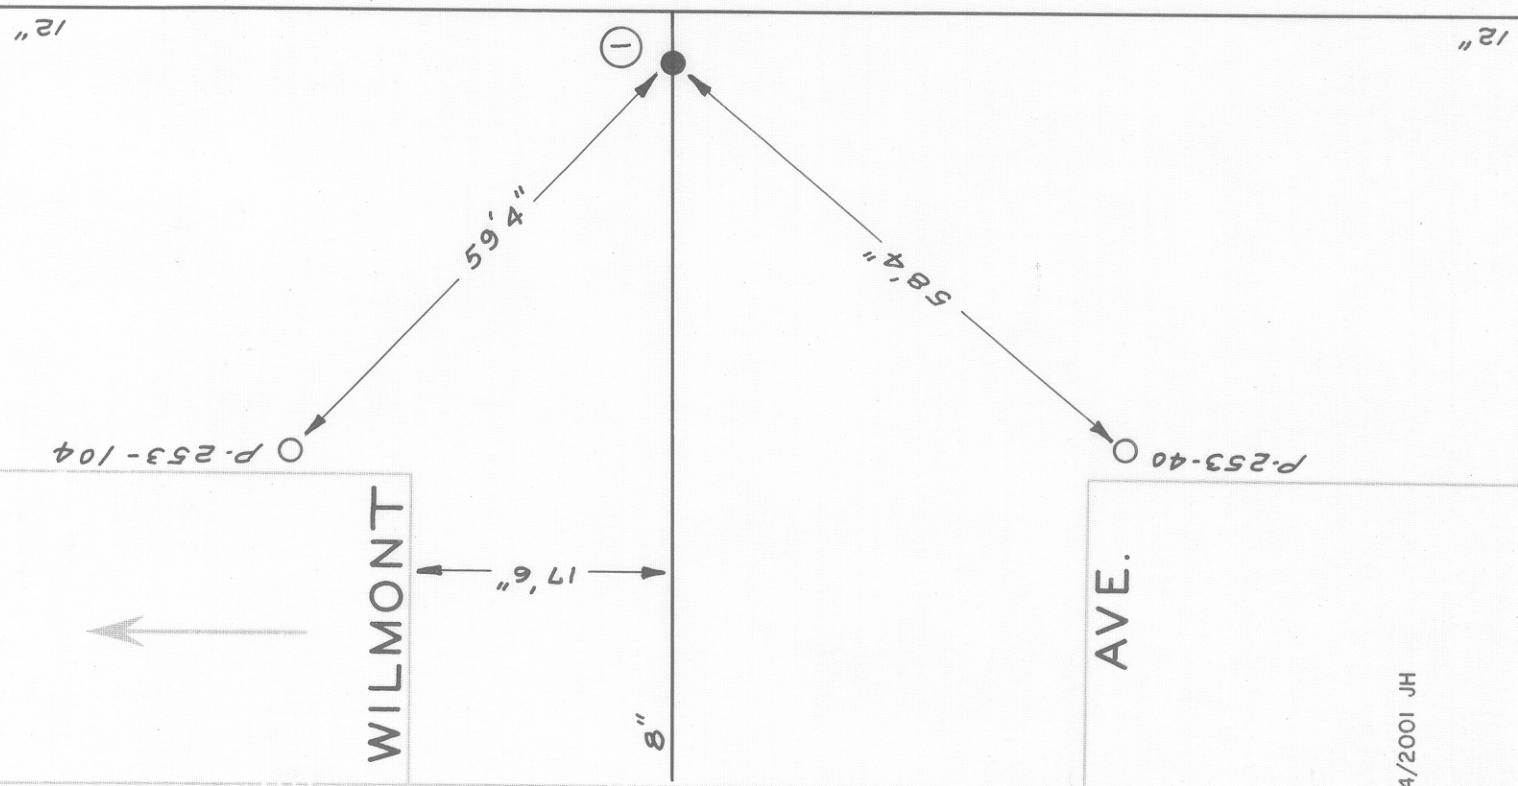

CITY OF ROANOKE — WATER DEPT
VALVE DIAGRAM
WILMONT AVE. & 36TH
36 TH STREET

SEC. MAP 264 N.W.
PAGE NO. 12
DATE 4/2001 JH

PAGE NO.