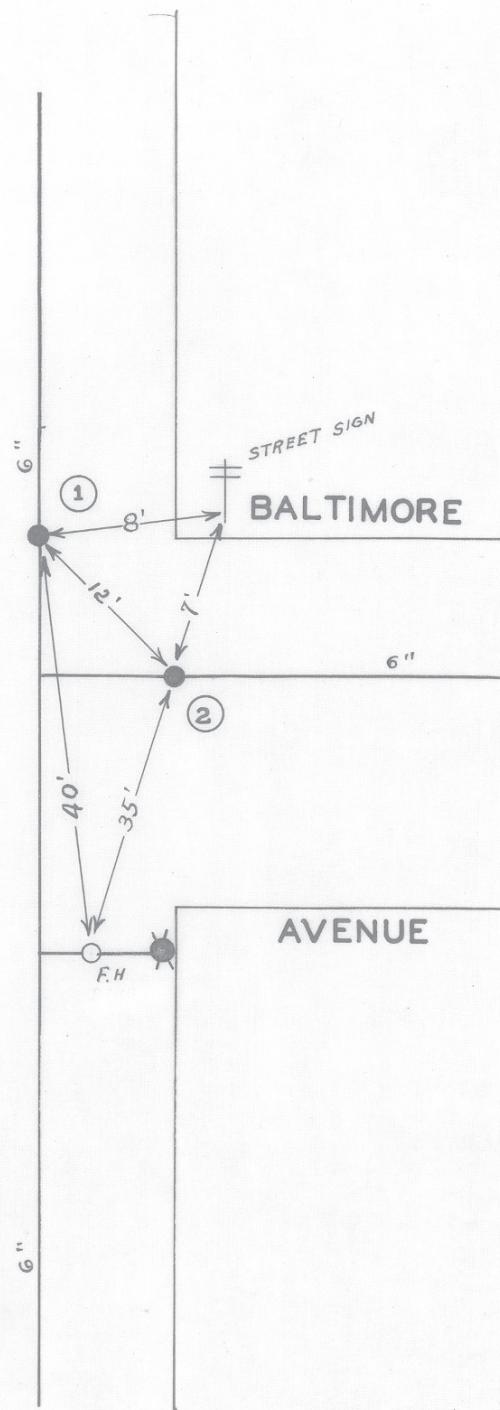


12/95 NP

SPRINGVALE STREET

[illegible]

CITY OF ROANOKE—WATER DEPT.
VALVE DIAGRAM

BALTIMORE AVENUE &
SPRINGVALE STREET S.E.

SEC. MAP 430

DATE _____

PAGE NO.