


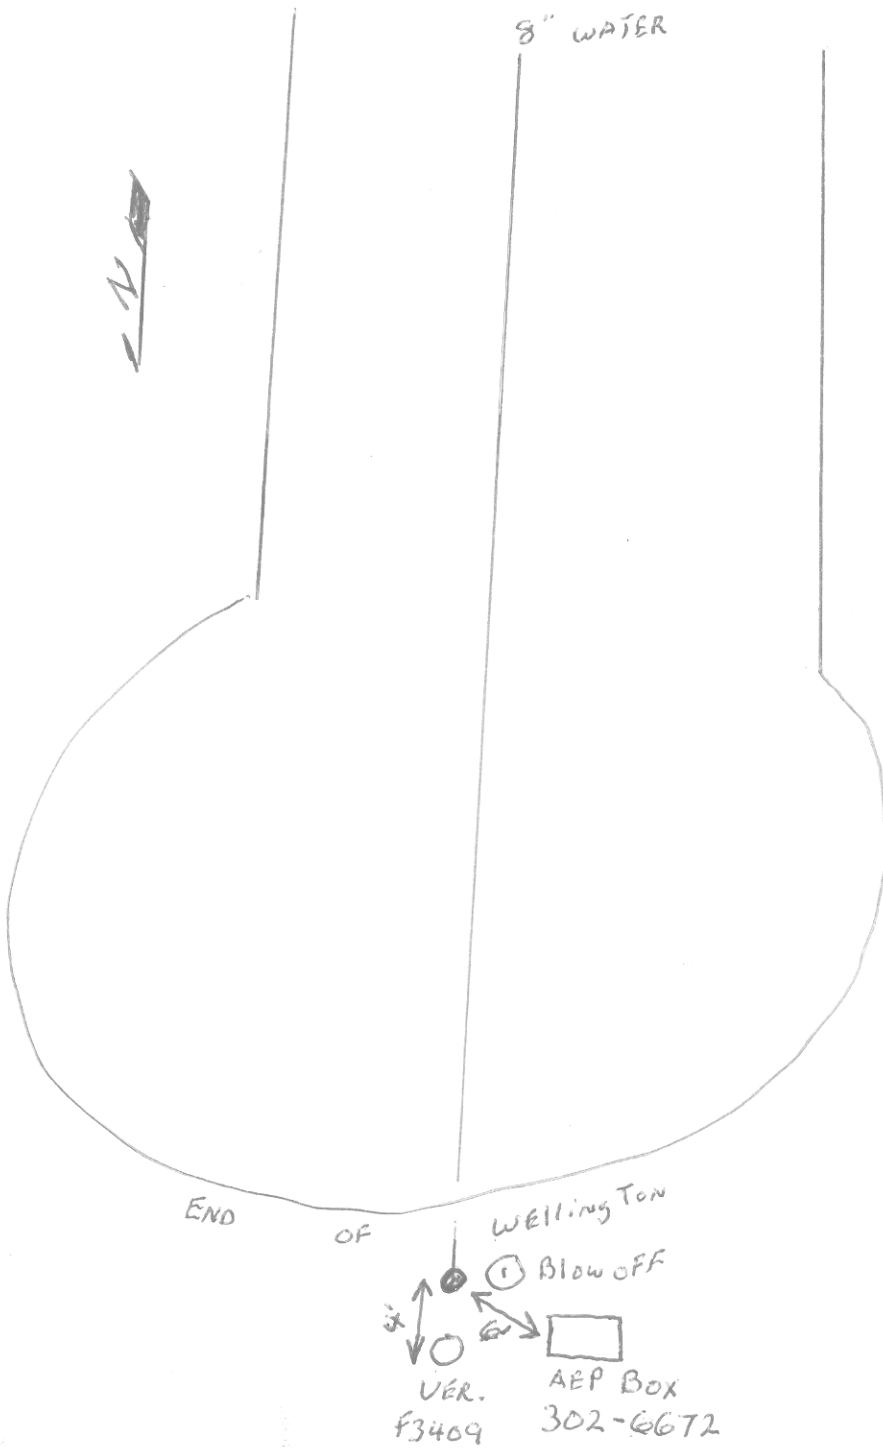

DATE	NO.	SIZE	MAKE	OPEN	TURNS
2003	1	2"	Misc BO	L	7

P. L. Measurements		
No.	Distance	Direction

CITY OF ROANOKE - WATER DEPT.	
VALVE DIAGRAM	
DEED END OF WELLINGTON SE	
Sec. Map	Page No.
Date	